

WATER SERVICE RECORD

2312-3
Service No. 186

Name Leeland Construction

Address 31 Oxbow Road

Location

~~XXXXXX~~ New Service


Comm 11-14-60

Date	Material	Amount	Total	Date		Amount
10-5-60	Labor	4.15		8-23-60	Deposit	35.00
	10% O.H.I.	.42	4.57	11-14-60	Paid by W.H.C.#215	2.15
	50' 3/4" Copper tubing @.42		21.00			37.15
	1 3/4" C x 1/2 I.W.H. Stop & Waste		6.17		NON CHARGE	
	1 3/4" C 3 part union		2.41	10-5-60	1 3/8" Straight tailpiece	.50
	1 hr. Trucking @.3.00		3.00		1 1/2" Offset tailpiece	.50
			37.15			1.00
				8-4-59		
					12' 3/4" Copper	
					1 3/4" C. Corp Cock	
					1 3/4" C. Curb Cock	
					1 Box + Rod	

TOWN OF LEXINGTON — BOARD OF PUBLIC WORKS

WATER DIVISION

Sketch of Service Here

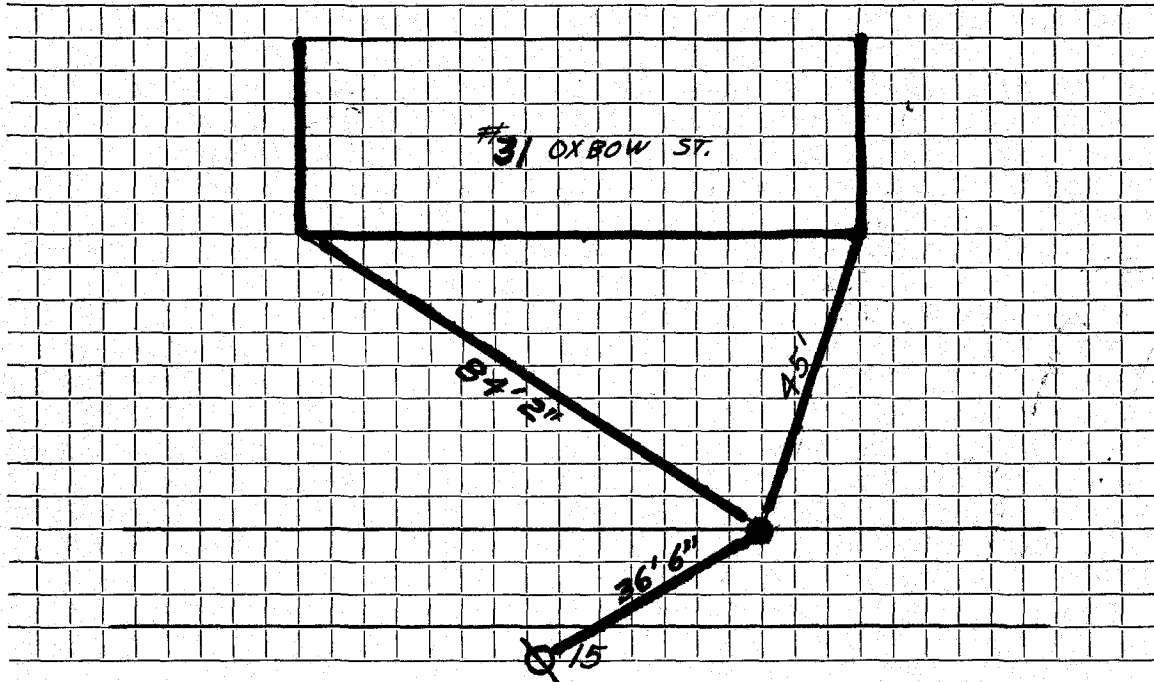

Connection made in Street. Work completed

Remarks:
.....
.....