


DATE 3/8/59

TOWN OF LEXINGTON — BOARD OF PUBLIC WORKS
WATER DIVISION

Sketch of Service Here

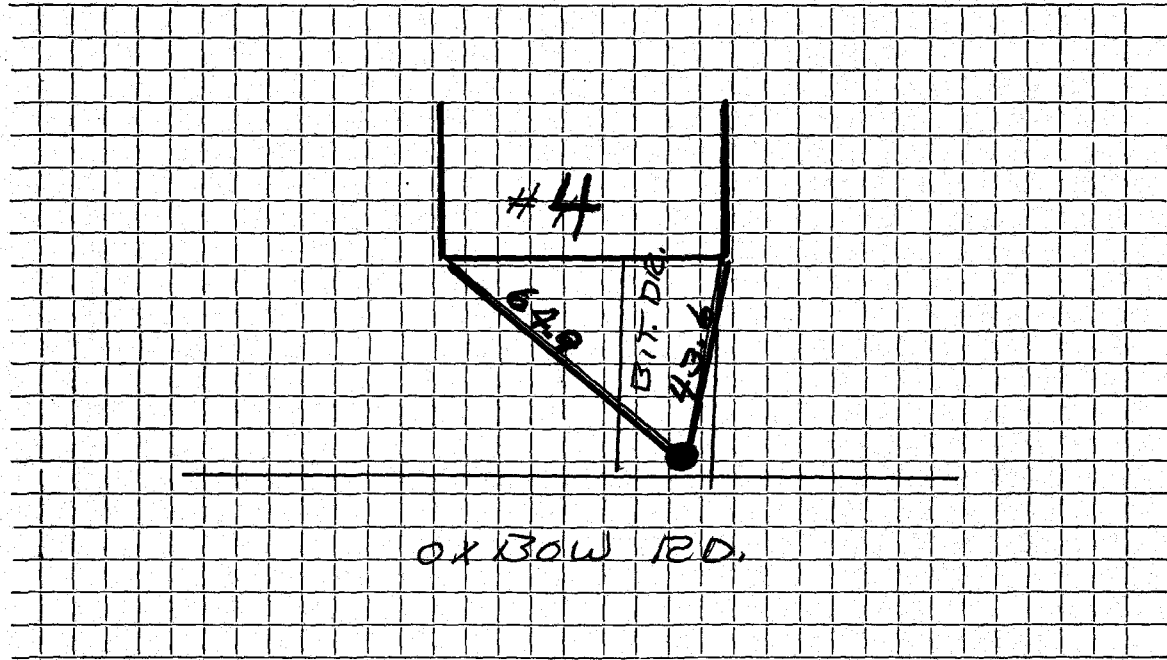

Connection made in ..OXBOW RD. Street. Work completed

Remarks:

.....

.....