

## WATER SERVICE RECORD

3/36  
3738  
196

Name Leeland Construction Company

Service No.

Address 8 Oxbow Road

Location

~~REPAIR WORK~~ - New Service

April 10-14-58


Date	Material	Amount	Total	Date	Amount
7-30-58	53' 3/4" Copper tubing @.37		19.61		
	1 3/4" C x 1/2 I.W.H. Stop & Waste		5.84		
	1 3/4" C 3 part Union		2.27		
			<u>27.72</u>		
					NON CHARGE
				24'	3/4" Copper tubing @.37
				1	3/4" C Corp Cock
				1	3/4" C Curb Cock
				1	Box & Rod
				1	1/2 Straight tailpiece
				1	1/2 Offset tailpiece
					<u>25.55</u>

DATE \_\_\_\_\_

# TOWN OF LEXINGTON — BOARD OF PUBLIC WORKS

## WATER DIVISION

Sketch of Service Here

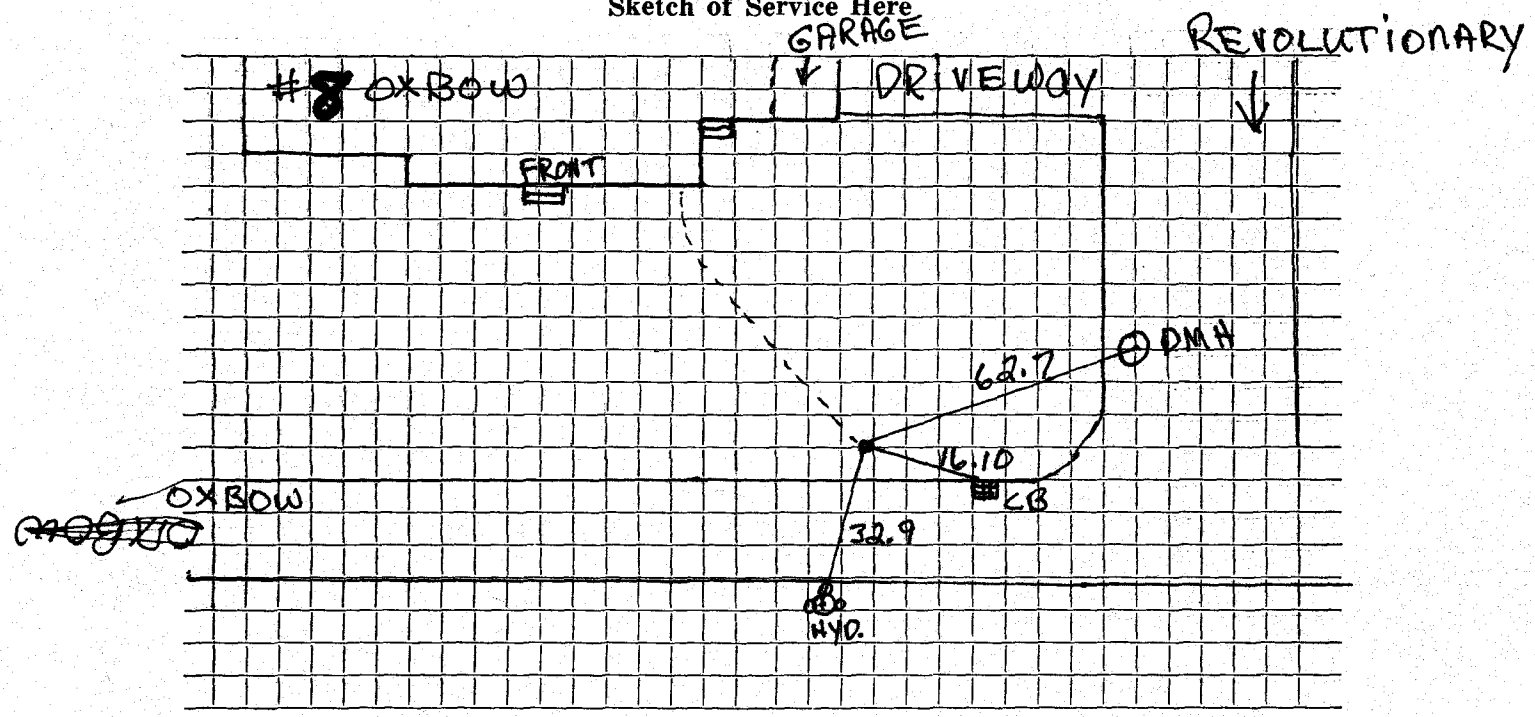

Connection made in ..... Street. Work completed .....

Remarks: .....  
.....  
.....