

WATER SERVICE RECORD

#4482

Service No. 184

Name Winsor D. Jellis

Address 12 Oxford Street

Location

~~Repair~~ ~~Renewal~~ ~~New Service~~


Comm 9-24-56

Date	Material	Amount	Total	Date	Amount
August 2, 1956	Labor	22 45		7-9-56	Deposit 40 00
	10% overhead	2 25	24 70	9-24-56	Refund 28 41
					68 41
	House to Curb				
50'	3/4" Copper Tubing @ .4850	24 25			
1	3/4" x 1/2" I.W.H. Stop & Waste	4 96			* paid by refund on S.N.C. #87
2 hrs.	Town Shovel @ 6.50	13.00			
2 hrs.	Town Trucking @ .75	1.50	43.71	3/28/50	
			68.41		8' 3/4 COPPER
					1 3/4 COB ADPT.
					1 3/4 CURB COCK

DATE _____

TOWN OF LEXINGTON — BOARD OF PUBLIC WORKS
WATER DIVISION

Sketch of Service Here

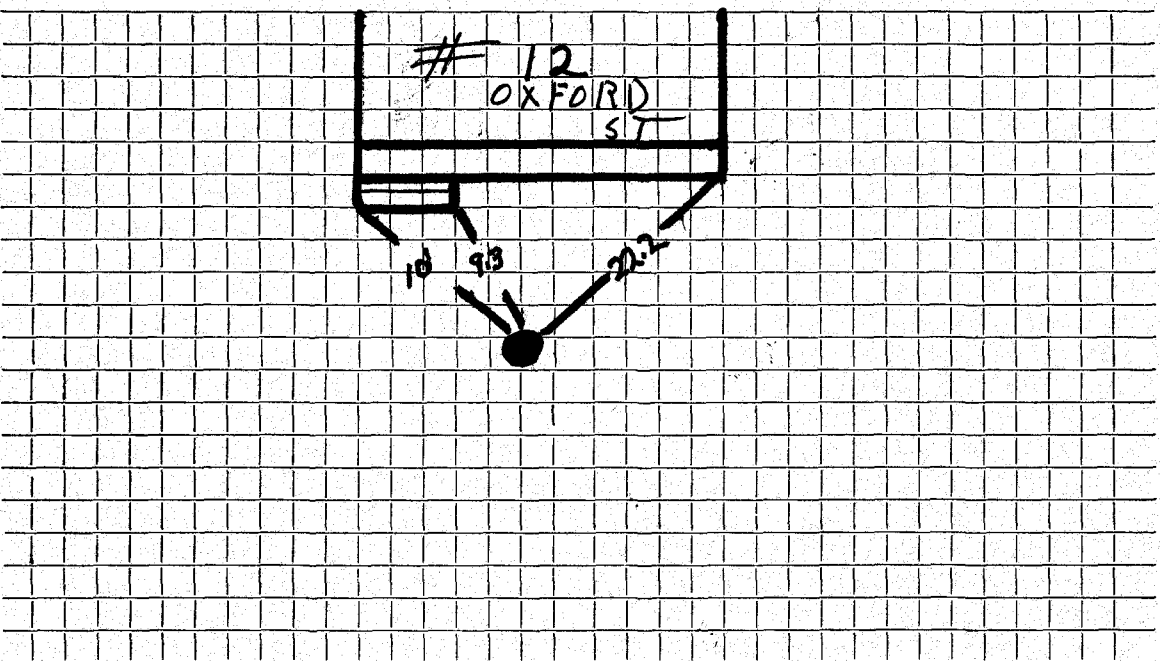

Connection made in Street. Work completed

Remarks:
.....
.....