


TOWN OF LEXINGTON — BOARD OF PUBLIC WORKS

WATER DIVISION

Sketch of Service Here

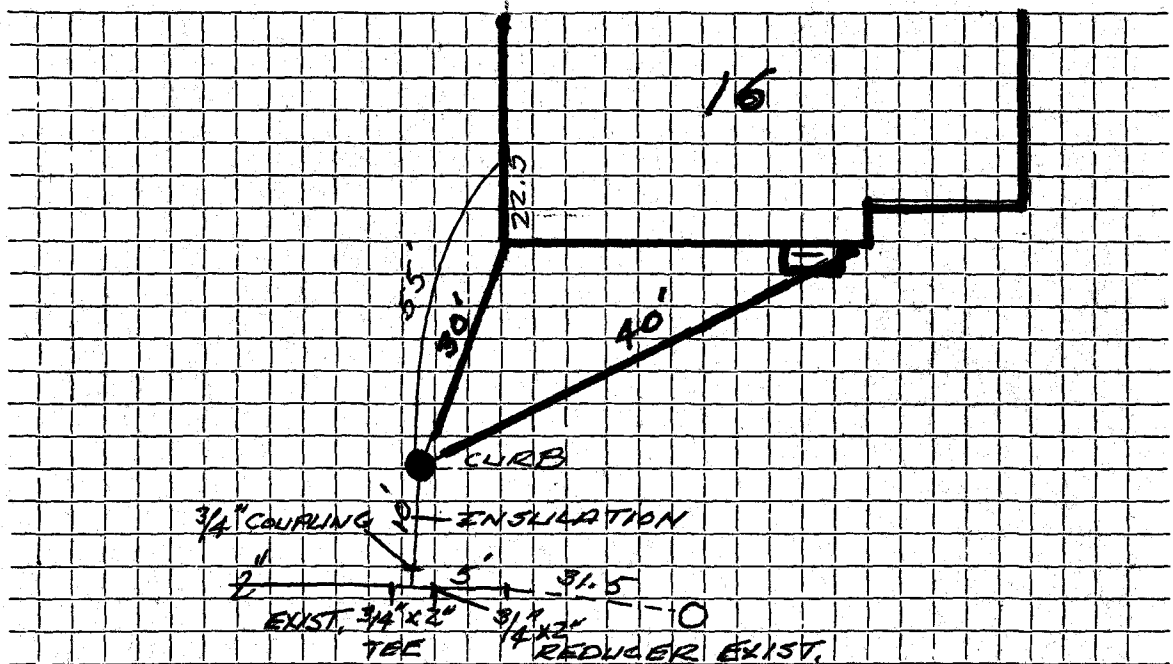

Connection made in OXFORD Street. Work completed

Remarks: FIRST 10 LF IS WRAPPED IN INSULATION
TEE IS DWN 3' 2" w/INSUL.