


TOWN OF LEXINGTON - BOARD OF PUBLIC WORKS
WATER DIVISION

Date: 4/29/21

SKETCH OF SERVICE HERE

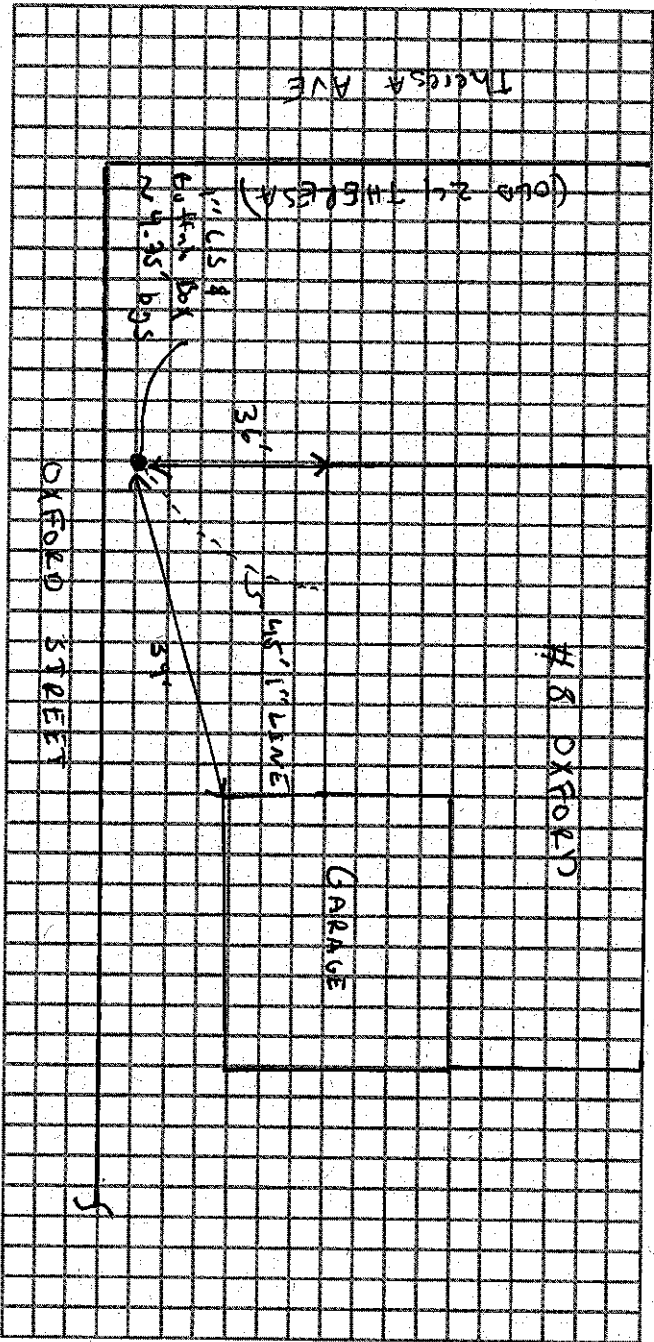

Connection made in: Oxford
Remarks:

Street:

Work completed:

Renewal

