

## WATER SERVICE RECORD

Service No.

3237  
70

Name George Alderson

Address 9 Oxford Street

Location

~~Repair—Renewal—New Service~~


Comm. 6-25-56

Date	Material	Amount	Total	Date	Amount	
4-11-56	Labor	1 90		4-10-56	Deposit	# 40 00
	10% overhead	19	2 09	5-25-56	Refund	12 80
	40' 3/4" Copper tubing @ .4850		19 40		NON CHARGE	27 20
	1 3/4Cx1/2 I.W.H. Stop & Waste		4 96	4-11-56	Labor	1 90
	1 hr. trucking		75	15' 3/4" copper tubing @ .4850		9 70
			27 20	1 - 3/4"C. Corp Cock		4 34
				1 - 3/4"C. Curb Cock		6 03
				1 box & rod		4 62
				1 - 1/2" straight tailpiece		50
				1 - 1/2" offset tailpiece		50
						27 59

DATE \_\_\_\_\_

TOWN OF LEXINGTON — BOARD OF PUBLIC WORKS  
WATER DIVISION

Sketch of Service Here

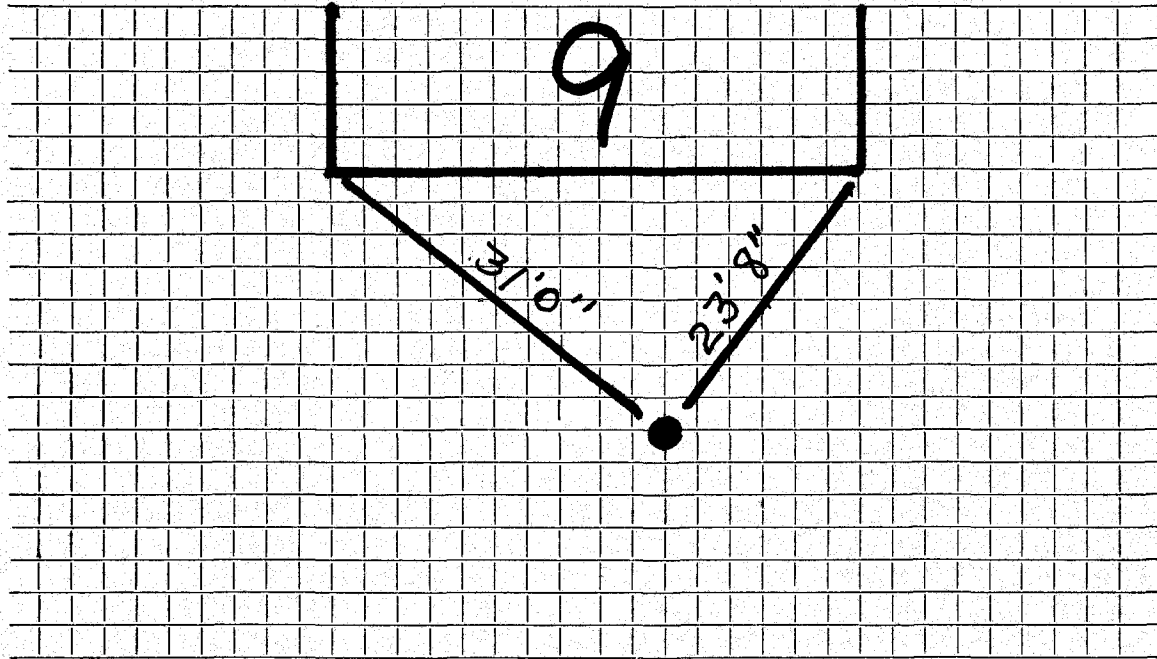

Connection made in ..... Street.      Work completed .....

Remarks: .....  
.....  
.....