

WATER SERVICE RECORD

Name

Service No.

Address

OXFORD STREET- NEW 2" C.L. PIPE SERVICE FROM LEE AVENUE TO END.

Location

Repair—Renewal—New Service


Date	Material	Amount	Total	Date	Amount
					<u>NON CHARGE</u>
				11/24/53	Labor 83 20
				11/25/53	" 83 20
				11/30/53	" 70 20
				51' - 2"	C.L. Pipe @ .8510 43 40
				2 - 2" x 1"	L.L. tees @ 2.13 4 26
				2 - 2"	L.L. couplings @ 1.85 3 70
				1 - 2" x 1"	L.L. red. coupling 1 29
				1 - 2"	gate valve 18 60
				1 -	gate box 14 25
				25' - 3/4"	copper tubing @ .3629 9 07
				1 - 3/4" O x 3/4"	C. union 1 09
				1 -	box and rod 3 90
				9 hrs.	town shovel @ 5.00 45 00
				5 hrs.	trucking @ .75 3 75
					<u>384 91</u>

DATE _____

TOWN OF LEXINGTON — BOARD OF PUBLIC WORKS

WATER DIVISION

Sketch of Service Here

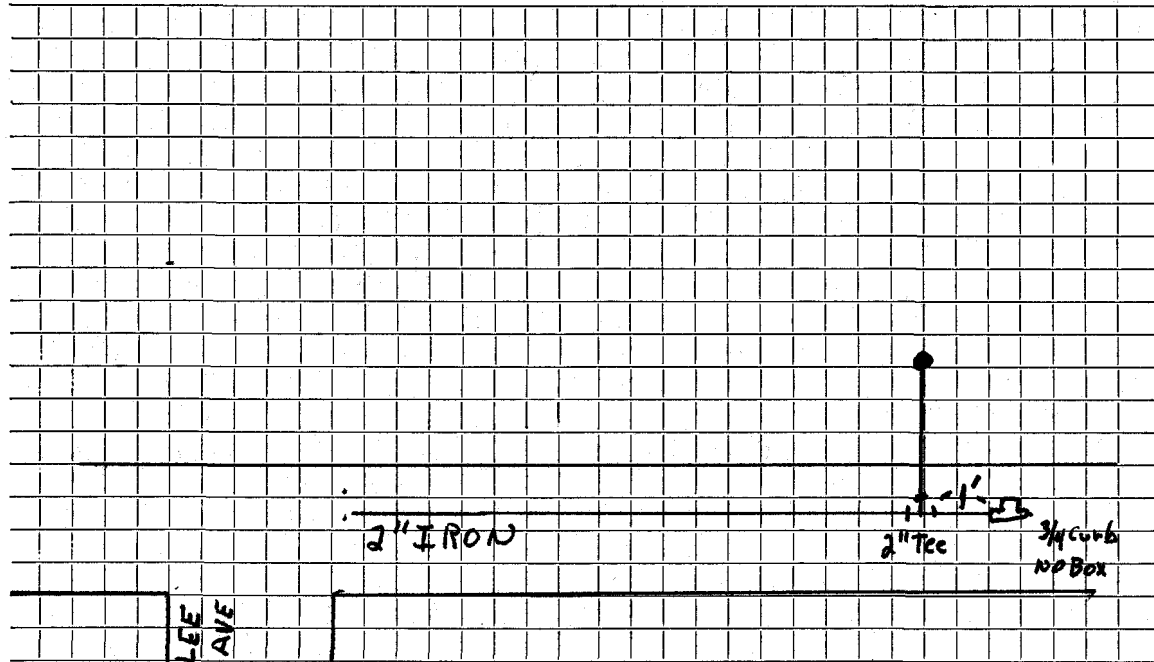

Connection made in Street. Work completed

Remarks:

.....

.....