

WATER SERVICE RECORD

Name **Brendan Walsh 9A-PADDOCK**

Service No. **3**

Address ~~86~~ **9A Paddock Lane (Per Eng. 5/24/84)**  
~~XXXXXXXXXXXX~~ **Opposite Tricorne**

Location **Lot # 78A**

~~XXXXXX~~ **Renewal New Service** ~~XXXXXX~~ **Baptise #3820**  
~~XXXXXXXXXXXX~~ **W. O. # 8663**

**OCT 31 1983**


Date		Material	Amount	Total	Date	Amount	
6/7/71		Labor	56 17		9-12-83	Deposit	
	10%	O.H.	5 61	61 78			115 28
	9'	3/4" Copper pipe .79		7 11			
	1	3/4" Corporation		9 57			
	1	3/4" Curb cock		11 32			
		Box & Rod		7 50			
	1/2	Ton cold patch 8.00		2 00			
	1	Hr. Truck		3 00			
	2	Hr. Shovel <del>XXXX</del> 6.50		130 00			
				113 28			
9/21/83	49'	3/4" Copper Tubing					
	1	3/4" R.H. Wheel Valve					

DATE JUNE 1977

TOWN OF LEXINGTON — BOARD OF PUBLIC WORKS

WATER DIVISION

Sketch of Service Here

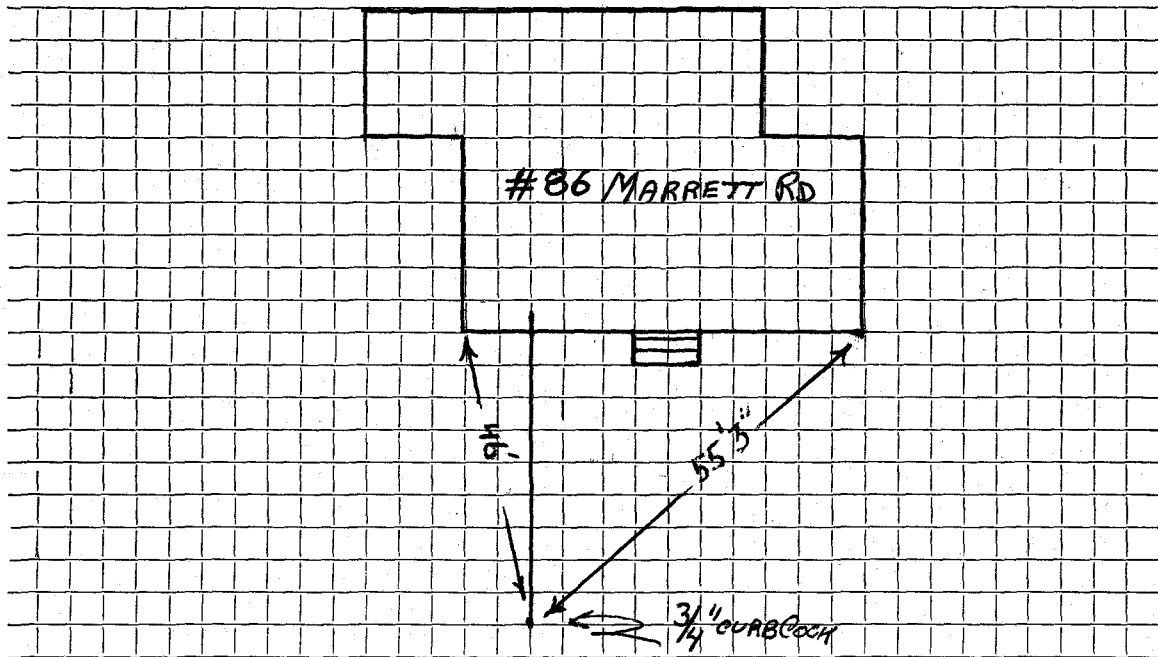

Connection made in MARRETT RD ..... Street. Work completed SEPT. 20, 1983 .....

Remarks: .....  
.....  
.....

