

WATER SERVICE RECORD

#5589

Name West Chester Estates

Service No. 308

Address 1 Page Road

Location

~~Repair - Rerun~~ - New Service


Comm 12-31-60

Date	Material	Amount	Total	Date	Amount	
10-9-59	Labor	1 85		12-8-60	Deposit	35 00
	10% O. H.	19	2 04	12-31-60	Paid by SHW#286	2 17
	Owner's copper					37 17
	33' out				<u>NON CHARGE</u>	
12-19-60	Labor	2.37		10-9-59	Labor	1 85
	10% O.H.	.24	2.61	1	3/4" C Corp Cock	4 64
	57' 3/4" Copper tubing @.42		23.94	1	3/4" C Curb Cock	5 94
	1 3/4" C x 1/2 I.W.H.Stop & Waste		6.17	1	Box & Rod	5 00
	1 3/4" C 3 part union		2.41			17 43
			37.17	1	1/2 Straight Tailpiece	.50
				1	1/2 Offset tailpiece	.50
						18.43

TOWN OF LEXINGTON — BOARD OF PUBLIC WORKS

WATER DIVISION

Sketch of Service Here

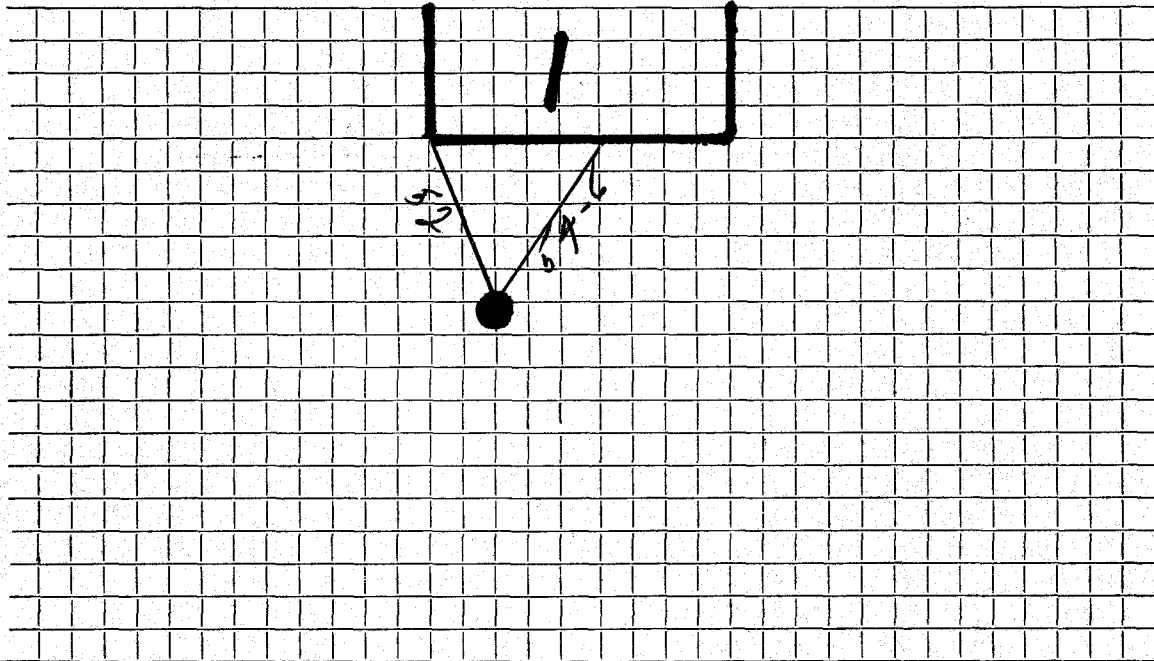

Connection made in Street. Work completed

Remarks:
.....
.....