


DATE 9/26/18

TOWN OF LEXINGTON — BOARD OF PUBLIC WORKS
WATER DIVISION

Sketch of Service Here

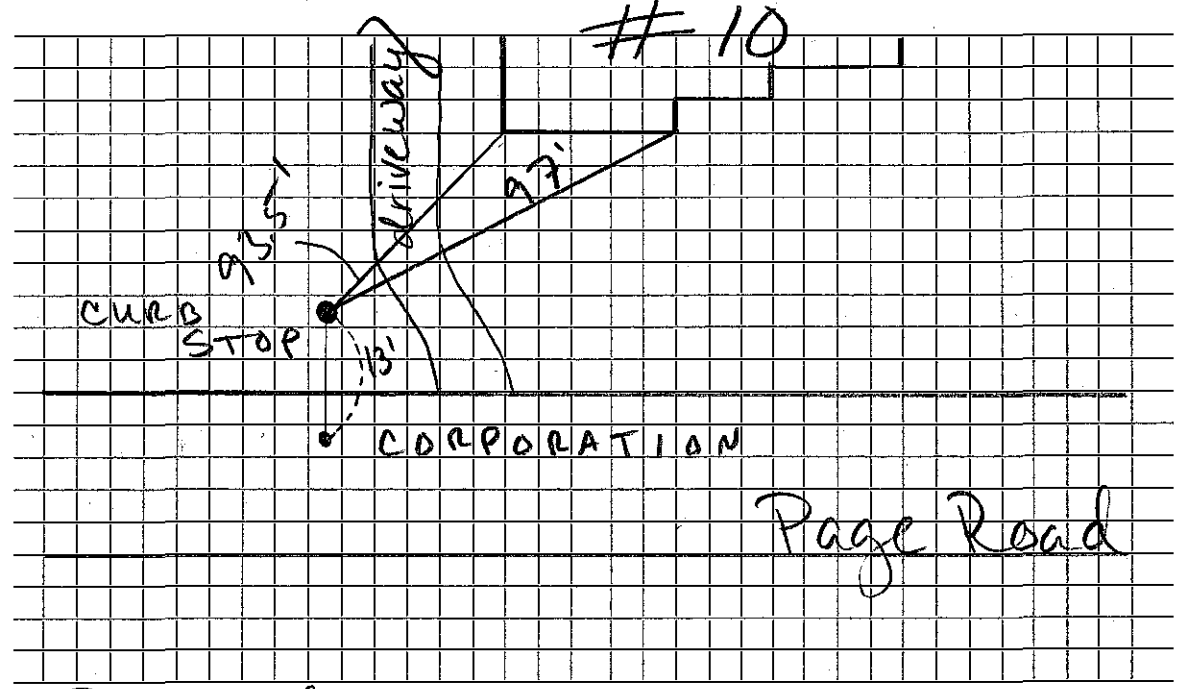

Connection made in Page Rd Street. Work completed

Remarks: