


Water Service Tie Card
TOWN OF LEXINGTON
 MASSACHUSETTS

3 Page Rd

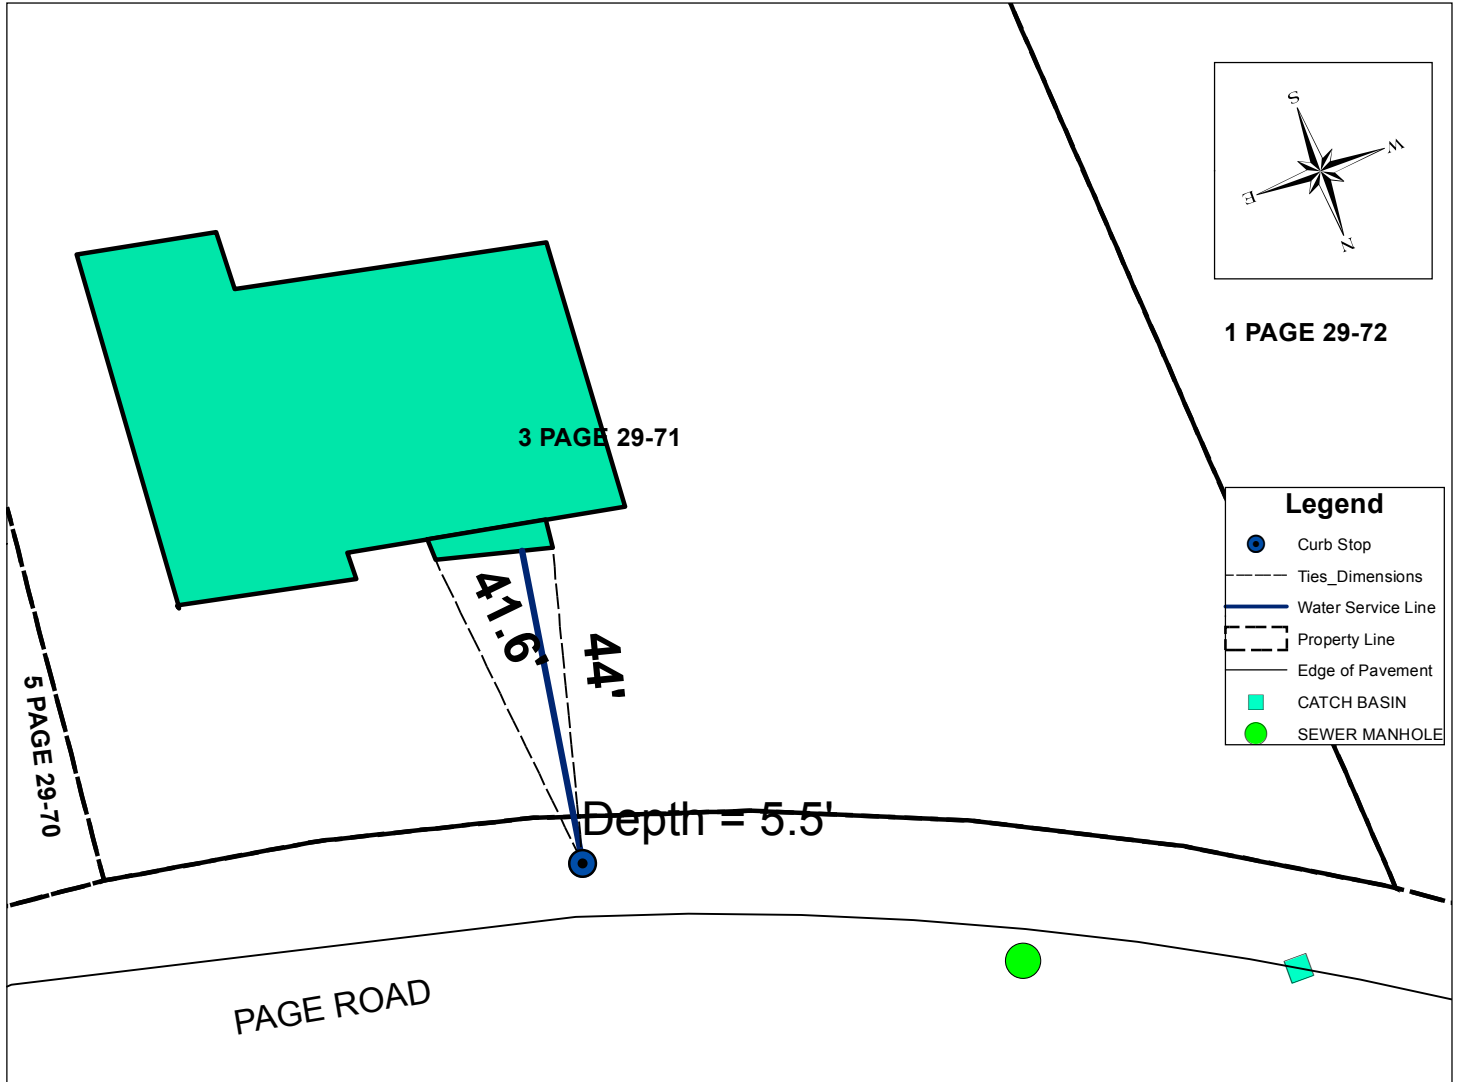

Address	Map and Lot	Permit Number	Contractor Name	Inspector
3 Page Rd	29-71	6064	Taylor Excavation	msprague
Date	Material	Depth of Cover	Amount	
1/23/2015	3/4" Copper type "k"	5.5 ft	1 ft	
	3/4" to 1" fitting	5.5 ft	1	
	1" Copper type "k"	5.5 ft	1 ft	
	1" Curb Valve and Buffalo Box	5.5 ft	1	
	1" Copper type "k"		48 ft	
Type of work completed				

New 1" water service to house from curb stop. New house on lot old house removed.