

## WATER SERVICE RECORD

# 127

Name West Chester Estates

Service No. 23

Address 14 Page Road

Location


~~Repair~~ ~~Renewal~~ New Service

Comm 5-8-61

Date	Material	Amount	Total	Date	Amount
10-9-59	Labor	1 85		4-3-61	Deposit 30 00
	10% O. H.	19	2 04	5-8-61	Paid by SHC#21 5 63
	Owner's copper 6' out			6-26-61	Paid 15 99
					<u>NON CHARGE</u> 51 62
4-5-61	Labor	2.32		10-9-59	Labor 1 85
	10% O.H.	.23	2.55	1	3/4" C Corp Cock 4 64
	67' 3/4" Copper tubing @.42		28.14	1	3/4" C Curb Cock 5 94
	1 3/4" C x 1/2 I.W.H. Stop & Waste		6.17	1	Box & Rod 5 00
	2 3/4" C 3 part unions @2.41		4.82		<u>17 43</u>
	1 Box & Rod		4.90	1	1/2 Straight tailpiece .50
	1 hr. Trucking @3.00		3.00	1	1/2 Offset tailpiece .50
			<u>51.62</u>		<u>18.43</u>
				5-8-61	Bill sent 15.99

TOWN OF LEXINGTON — BOARD OF PUBLIC WORKS  
WATER DIVISION

Sketch of Service Here

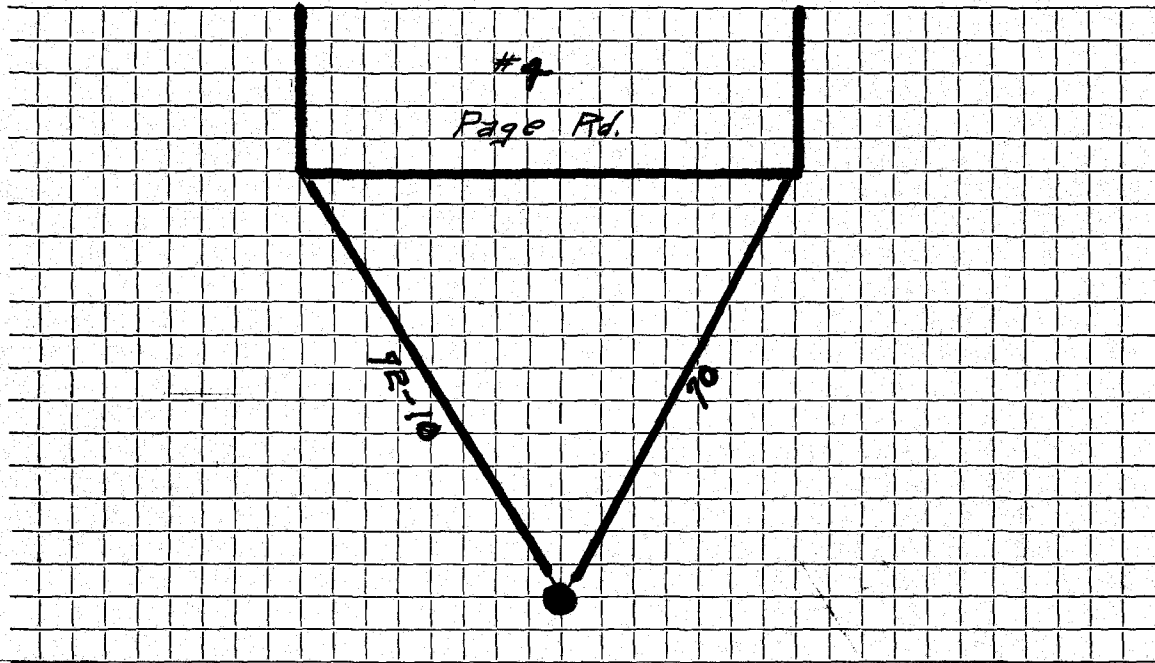

Connection made in ..... Street. Work completed .....

Remarks: .....  
.....  
.....