

WATER SERVICE RECORD

#870
#871

Name West Chester Estates

Service No. 265

Address 5 Page Road

Location


~~Repair - Renewal~~ New Service

Comm 12-12-60

Date	Material	Amount	Total	Date	Amount	
10-9-59	Labor	1 85		11-2-60	Deposit	30 00
	10% O. H.	<u>19</u>	2 04	12-14-60	Paid by SUC# 209	<u>5 89</u>
	Owner's copper					35 99
	25' out				<u>NON CHARGE</u>	
11-16-60	Labor	4 26		10-9-59	Labor	1 85
	10% O.H.	<u>43</u>	4 69	1	3/4" C Corp Cock	4 64
49'	3/4" Copper tubing @.42		20 58	1	3/4" C Curb Cock	5 94
1	3/4" C x 1/2 IWH Stop & Waste		6 17	1	Box & Rod	<u>5 00</u>
1	3/4" C 3 part Union		<u>2 41</u>			17 43
			35 89	11-16-60	1 1/2 Straight tailpiece	50
					1 1/2 Offset tailpiece	<u>50</u>
						18 43

TOWN OF LEXINGTON — BOARD OF PUBLIC WORKS
WATER DIVISION

Sketch of Service Here

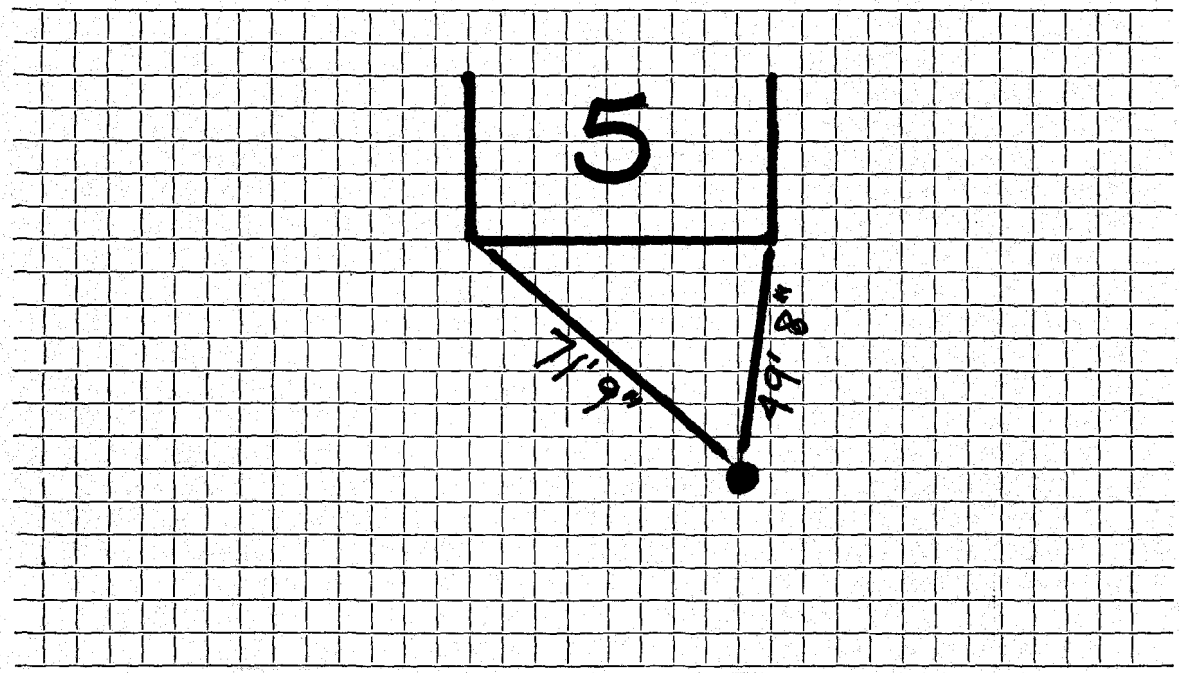

Connection made in Street. Work completed

Remarks:
.....
.....