DE # 10 NO Town of Lexington. Mass. Name Service No. 1879 Park Dept. Drinking Fountain near Swimming Pool Address Location Kind of Pipe Size Size of Main **Repair**—Renewal—New Service Location 1941 Material Amount Total Date Amount Nov. 8 4 hrs. @ 60¢ 2 40 lan 8. 1942 Laid 15. 69 Com /1/41 10% Overhead 24 64 2 15' 3/4" Copper tubing @ 19¢ 85 1 3/4" C.Corp cock 25 1 3/4" C.curb cock 75 1 3/4" C.x 3/4 I.Union 65 1 3/4" C. Meter Stand 3 05 2 hrs. trucking 2 75¢ 50 15 69 Bucked Lec 39.1241 Labor

TOWN OF LEXINGTON-BOARD OF PUBLIC WORKS WATER DIVISION

The undersigned applies for a supply of water at No.\_\_\_\_\_\_St. and hereby agrees to comply with the rules and regulations as now, or at any future time, established by the Board of Selectmen.


Am't. of Estimate \$

Owner

Am't. Paid \$\_\_\_\_\_

Address

Builder\_\_\_\_

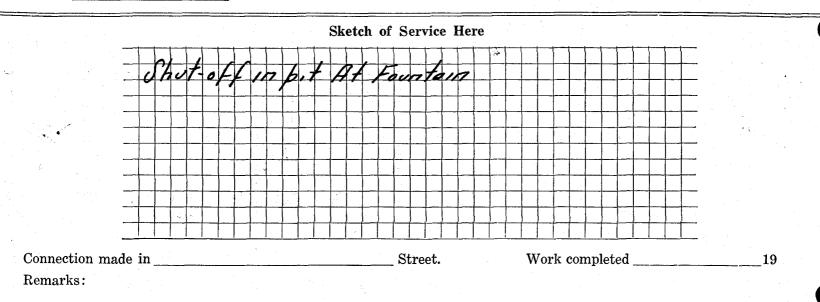

DATE