


TOWN OF LEXINGTON — BOARD OF PUBLIC WORKS

WATER DIVISION

Sketch of Service Here

TRACK

PARK DR

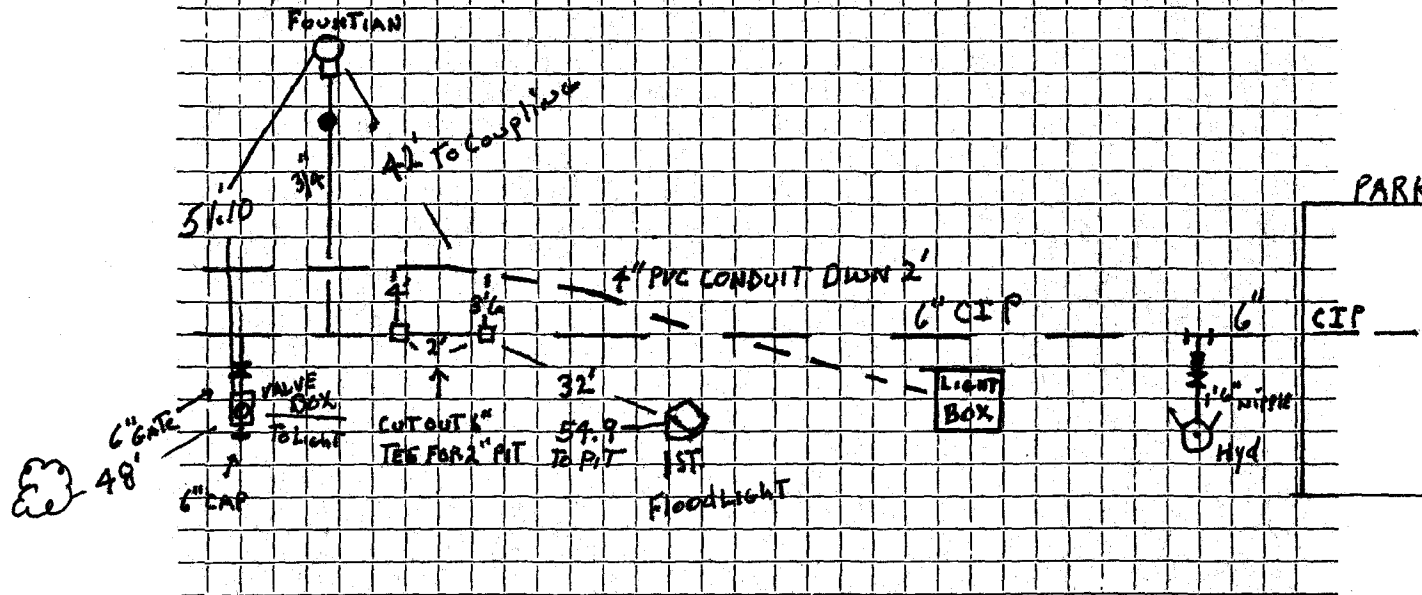

Connection made in _____ Street. Work completed 8-11-93

Remarks: \uparrow OLD WIRE'S FOR LIGHT. 4-220-2 ARE BROKEN BY 1ST COUPLING & DOWN 2' ON TOP OF WATER (MAIN) DOWN 4'.
DEAD