

WATER SERVICE RECORD

Name

Service No.

Address **Park Drive**

Location **@ Football Field**

Repair—Renewal—New Service **W.O. #6618 FOR DRINK FOUNTAIN + STAND**


Date	Material	Amount	Total	Date	Amount
9/12/78	Labor				
11/11/78	Labor				
	77' 3/4" Copper tubing				
	1 3/4" Curb Cock				
	1 3/4" Corp.				
	1 Box & Rod				
	1 3/4" Wheel Handle Stop & Waste				
	1 ton Cold Patch				
	Patch 5' x 26 1/2'				
	3 1/2 hrs. Trucking				
	1/2 hr. Roller				
	2 hrs. Town Shovel				
	1/2 hr. Compressor				

DATE _____

TOWN OF LEXINGTON — BOARD OF PUBLIC WORKS

WATER DIVISION

Sketch of Service Here

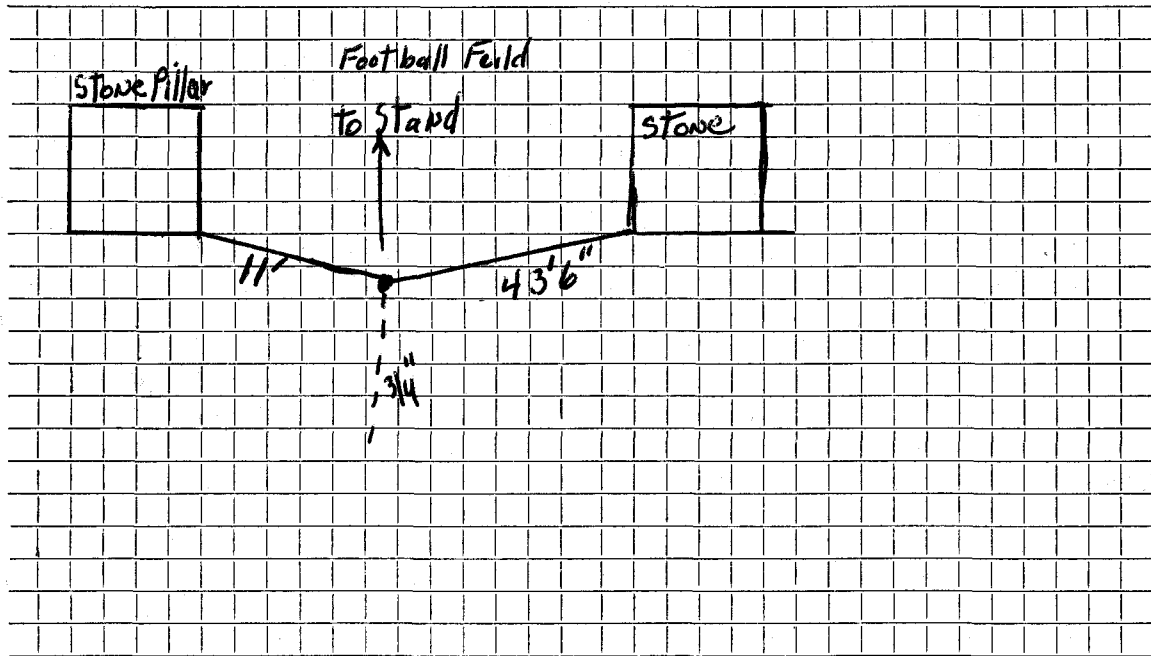

Connection made in Street. Work completed

Remarks:
.....
.....