

**WATER SERVICE RECORD**

Name **Refreshment Stand at Football Field**

Service No.

Address **Park Drive**

Location

~~Repair~~—Renewal—~~New Service~~ **W.O. #1735**

Date		Material	Amount	Total	Date	Amount
6/23/81	35'	2" Copper tubing				
	1	2" Corporation				
	1	2" Curb				
	1	Roadway Box				
	1	6" x 2" Service Saddle				
	1	2" Tee Brass				
	1	2" x 1" Bushing				
	1	1" x ½" Bushing				
	2	2" Meter flanges				
	1	6' Manhole				
	1	Frame & Cover				
	1	2" Gate Valve				
		23' x 6' Patch				
		12' Berm				
	8	hrs. Trucking				
	3	hrs. Town Shovel				
	1	hr. Roller				

DATE \_\_\_\_\_

**TOWN OF LEXINGTON — BOARD OF PUBLIC WORKS**

**WATER DIVISION**

Sketch of Service Here

A large grid of graph paper, consisting of 20 columns and 20 rows of small squares, intended for sketching service details.

Connection made in ..... Street.      Work completed .....

Remarks: .....  
.....  
.....






DATE \_\_\_\_\_

TOWN OF LEXINGTON — BOARD OF PUBLIC WORKS

**WATER DIVISION**

Sketch of Service Here

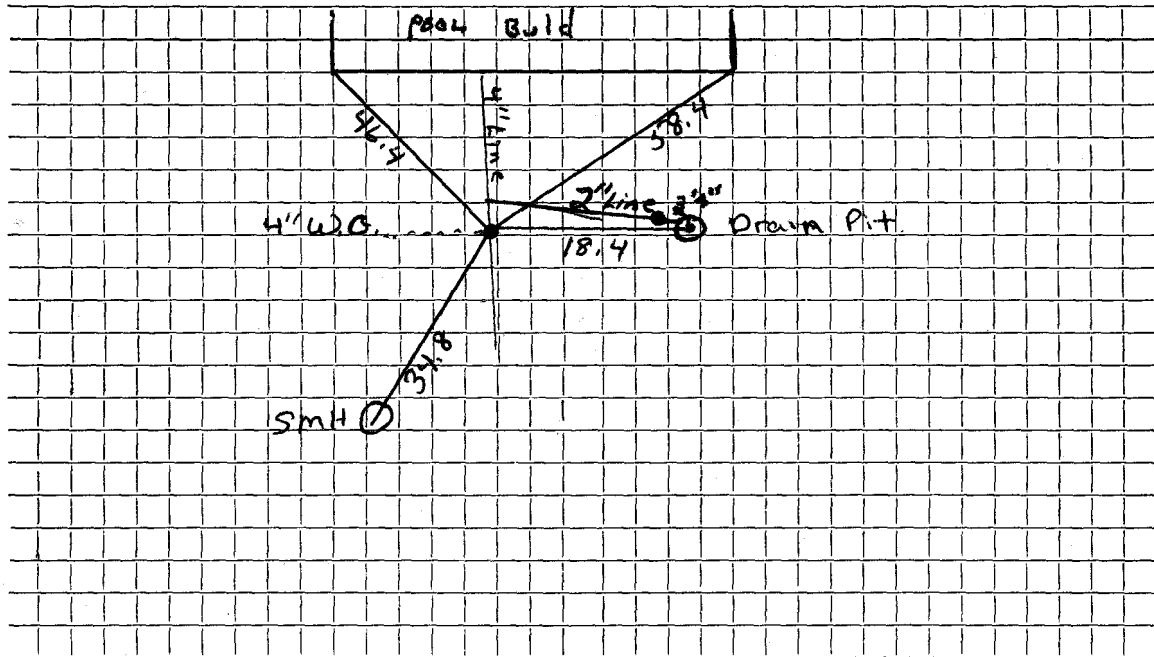

Connection made in ..... Street. Work completed .....

Remarks: .....

.....  
.....

DATE \_\_\_\_\_

**TOWN OF LEXINGTON — BOARD OF PUBLIC WORKS**

**WATER DIVISION**

Sketch of Service Here

A large grid of graph paper, consisting of 20 columns and 20 rows, intended for sketching service details.

Connection made in ..... Street.                      Work completed .....

Remarks: .....  
.....  
.....