




TOWN OF LEXINGTON — BOARD OF PUBLIC WORKS

WATER DIVISION

Sketch of Service Here

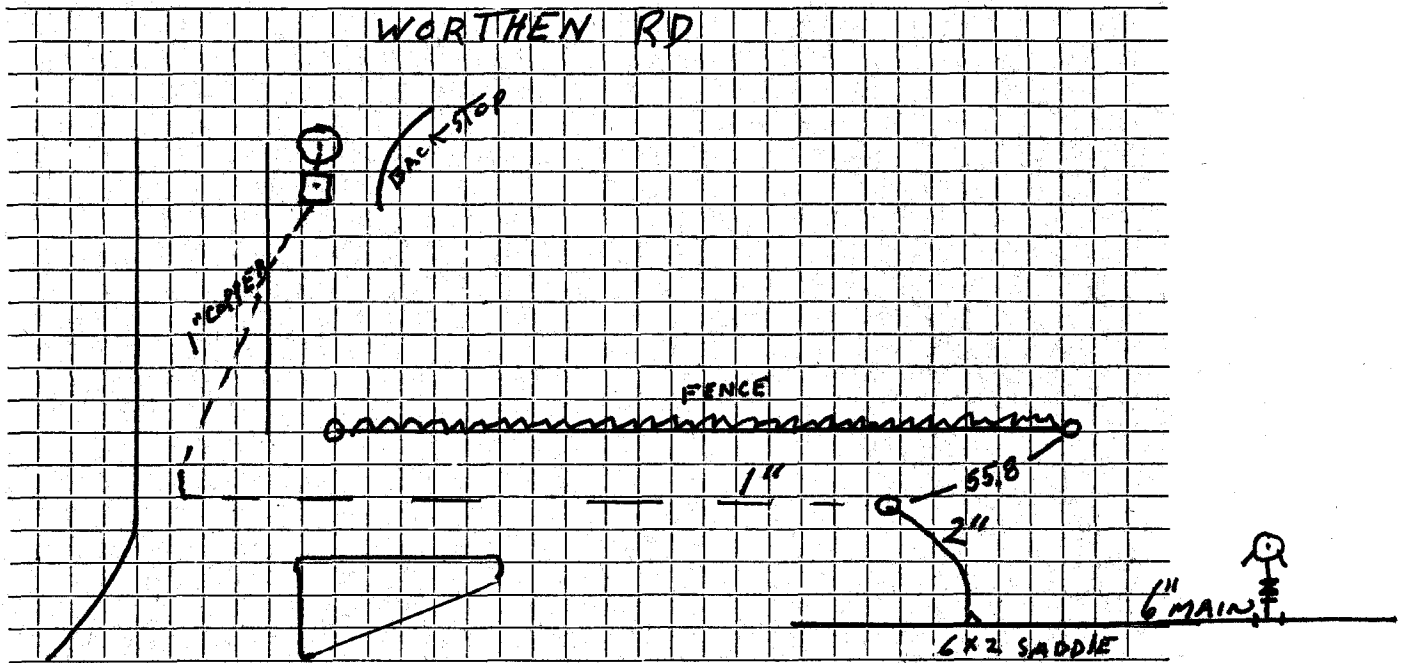

Connection made in ..... Street. Work completed .....

Remarks: COPPER LAID FROM BACKSTOP TO 2' CURB 100' ROLL'S