

WATER SERVICE RECORD

Name Victor R. Saltsgater

Service No. 58

Address 10 Parker Street

Location

~~Renewal~~ ~~RENEWAL~~ W.O. #8830

Comm 9-31-64


Date	Material	Amount	Total	Date	Amount
6-18-64	Labor	56.36		8-11-64	150.00
	10% O.H.	5.64	62.00	9-21-64	8.35
	44' 3/4" Copper tubing @.42		18.48		141.65
	1 3/4" C x 1/2 I.W.H. Stop & Waste		6.17		
	3 hrs. Town Shovel @6.50		19.50		
	2 hrs. Trucking @3.00		6.00		
	4 x 3 Patch Sidewalk		4.00		
	3 hrs. Town Shovel @6.50		19.50		
	2 hrs. Trucking @3.00		6.00		
			<u>141.65</u>		

DATE _____

TOWN OF LEXINGTON — BOARD OF PUBLIC WORKS

WATER DIVISION

Sketch of Service Here

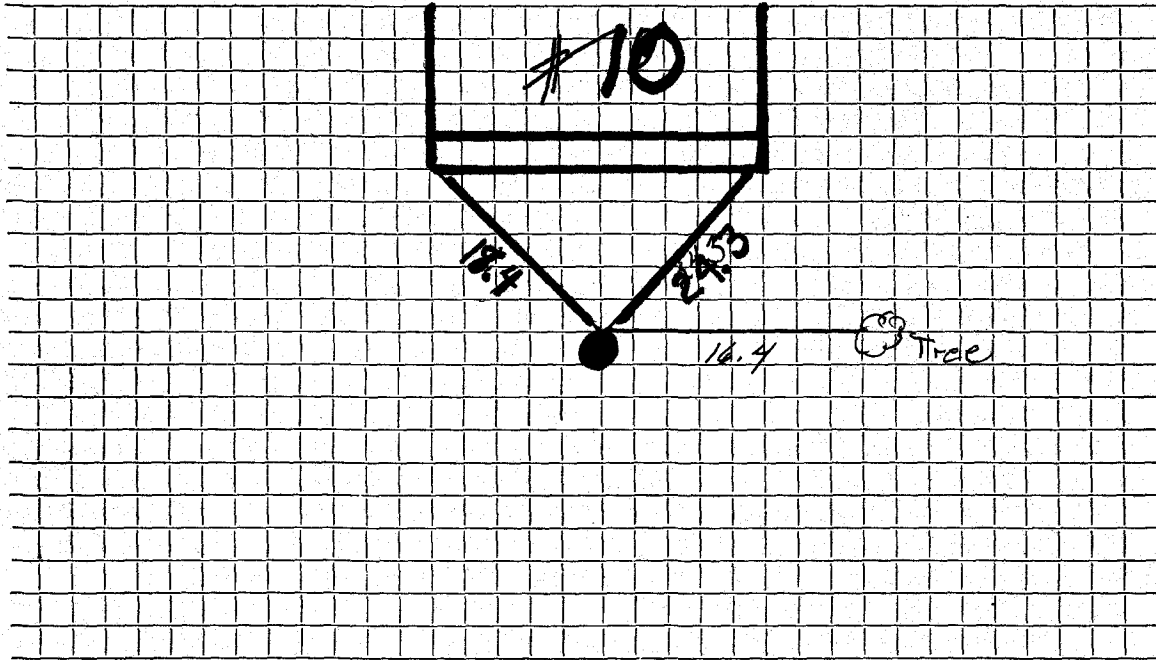

Connection made in Street. Work completed

Remarks:

.....

.....