

3404

WATER SERVICE RECORD

Name Frank Yeoman

Service No. 288

Address 14 Parker Street

3404

Location

Request: Renewal - New Service


Comm. 12-3-56

Date	Material	Amount	Total	Date	Amount
9/18/56	Labor	15 60		9-18-56	Deposit \$ 100 00
	10% overhead	1 56	17 16	12-3-56	Refund (37 08
	30' - 3/4" Copper tubing @ .4850	14 55			NON CHARGE 62 92
	1 - 3/4" Cx 1/2 I.W.H. Stop & Waste	4 96		1 -	Straight tailpiece 50
	1 hr. trucking		75	1 -	Offset tailpiece 50
	3 hrs. Littlefield Shovel @ 8.50	25 50			1 00
			62 92		

DATE _____

TOWN OF LEXINGTON — BOARD OF PUBLIC WORKS
WATER DIVISION

Sketch of Service Here

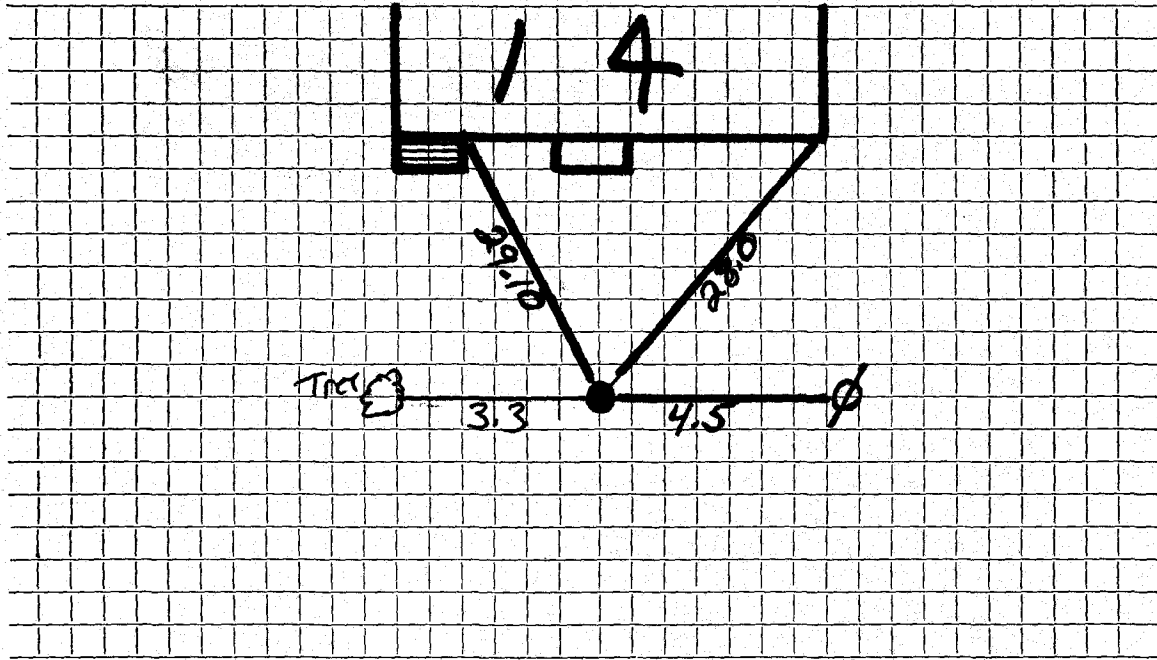

Connection made in Street. Work completed

Remarks:
.....
.....