

## WATER SERVICE RECORD

Name Katherine A. Manley

Service No. 13

Address 15 Parker Street

# 685

Location

~~Repair—Renewal—New Service~~

W.O. #9618

Comm 11-31-65

Date	Material	Amount	Total	Date	Amount
3-24-65	Labor	44.88		3-23-65	Deposit 100.00
5-11-65	"	8.90	53.78	1-13-64	Paid 7.56
	10% O.H.	5.38	59.16		107.56
30'	3/4" Copper tubing @.42		12.60		
1	3/4" X 1/2 Comp. Valve		9.29		CURE TO MAIN
1	3/4"-3 Part Union		3.01	1	1/2 Offset tailpiece 93
5'	X 3 Patch		5.00	1	1/2 Tailpiece Straight 93
1	Lead Loan		3.00		186
1	Hr. Town Shovel		6.50		
3	Hrs. Town Truck @3.00		9.00		
			107.56		


Bill sent 7.56

DATE \_\_\_\_\_

# TOWN OF LEXINGTON — BOARD OF PUBLIC WORKS

## WATER DIVISION

Sketch of Service Here

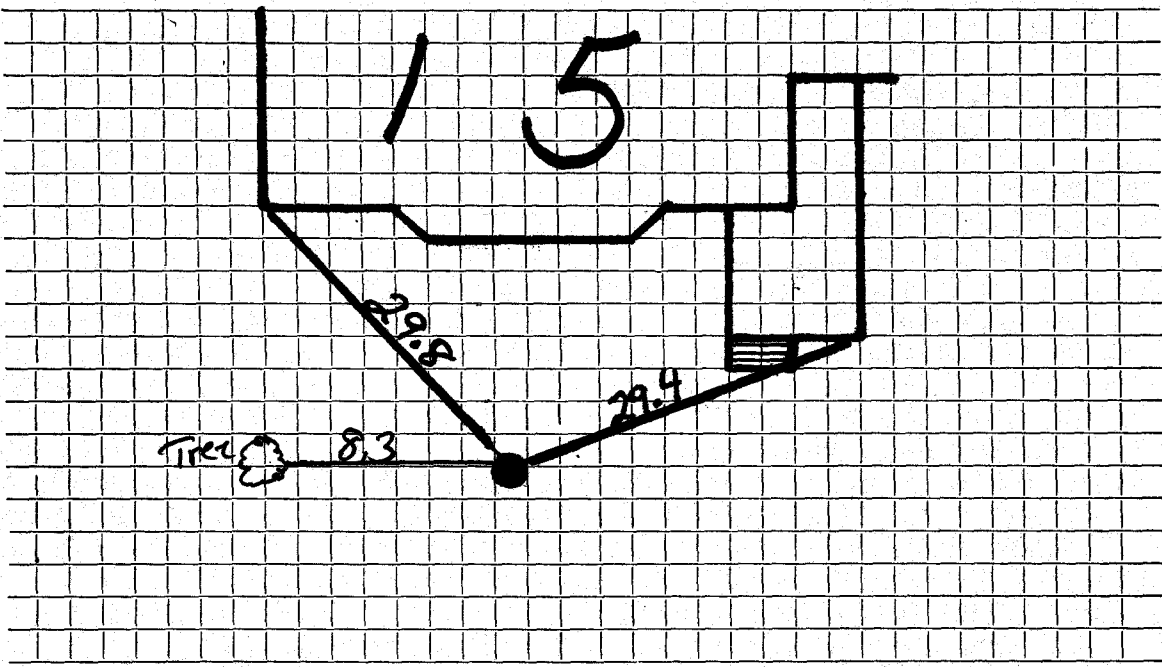

Connection made in ..... Street. Work completed .....

Remarks: .....  
.....  
.....