

Name Willis N. Cousins

Connection #8

Service No. 2159

Address 16 Parker Street

#1556

Location 16 Parker St.

Kind of Pipe

Size

Size of Main

~~Repair~~—Renewal—~~New Service~~

W.O. #1899.

Location Comm 7-25-75

Hadley Press, Inc., Lexington

Date	Material	Amount	Total	Date	Amount
3-25-74	Labor	\$72.40		3-25-74	150.00
	10 % O.H.	<u>7.24</u>	\$79.64	3-28-75	8.60
31	3/4" Copper Pipe	@1.05	32.55		141.40
1	3/4" Wheel Valve		13.21		
1	Hr. Trucking		3.00		
2	Hrs. Backhoe	@6.50	<u>13.00</u>		
			\$141.40		
	Labor				

Deposit
Retained

DATE _____

TOWN OF LEXINGTON—BOARD OF PUBLIC WORKS

WATER DIVISION

The undersigned applies for a supply of water at No. _____ St. and hereby agrees to comply with the rules and regulations as now, or at any future time, established by the Board of Selectmen.

Am't. of Estimate \$ _____

Owner

M. J. Manley.


Am't. Paid \$ _____

Address

16. Parker St.

Builder _____

Sketch of Service Here

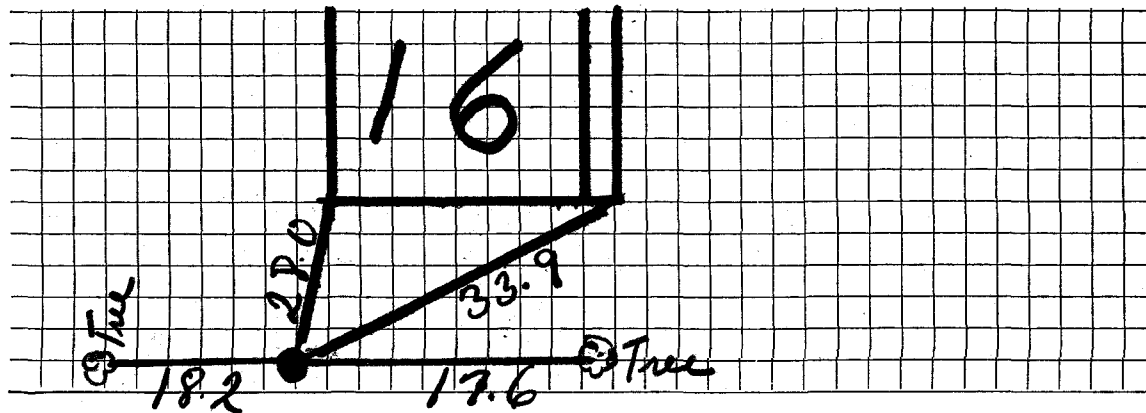

Connection made in _____ Street.

Work completed _____ 19

Remarks: