

WATER SERVICE RECORD

Name James J. Shimansky

Service No.

21

Address 19 Parker St. Lexington, Mass.

Location

~~Repair~~ ~~Renewal~~ ~~New Service~~ WO #4619


Date	Material	Amount	Total	Date	Amount	
6/23/76	labor	36. 46		6/22/76	Deposit	200. 00
	10%OH	3. 65	40. 11	8/16/76	Refund	100. 76
49'	copper @ .65		31. 85			99. 24
1	3/4" stop and waste		14. 53			
1 1/2	hr. shovel @ 6.50		9. 75	7-19-73		
1	hr. truck @ 3.00		3. 00		18' 3/4" Copper	
			99. 24		1 3/4" C. Corp Cock	
					1 3/4" C. - 3 Part Union	

DATE _____

TOWN OF LEXINGTON — BOARD OF PUBLIC WORKS

WATER DIVISION

Sketch of Service Here

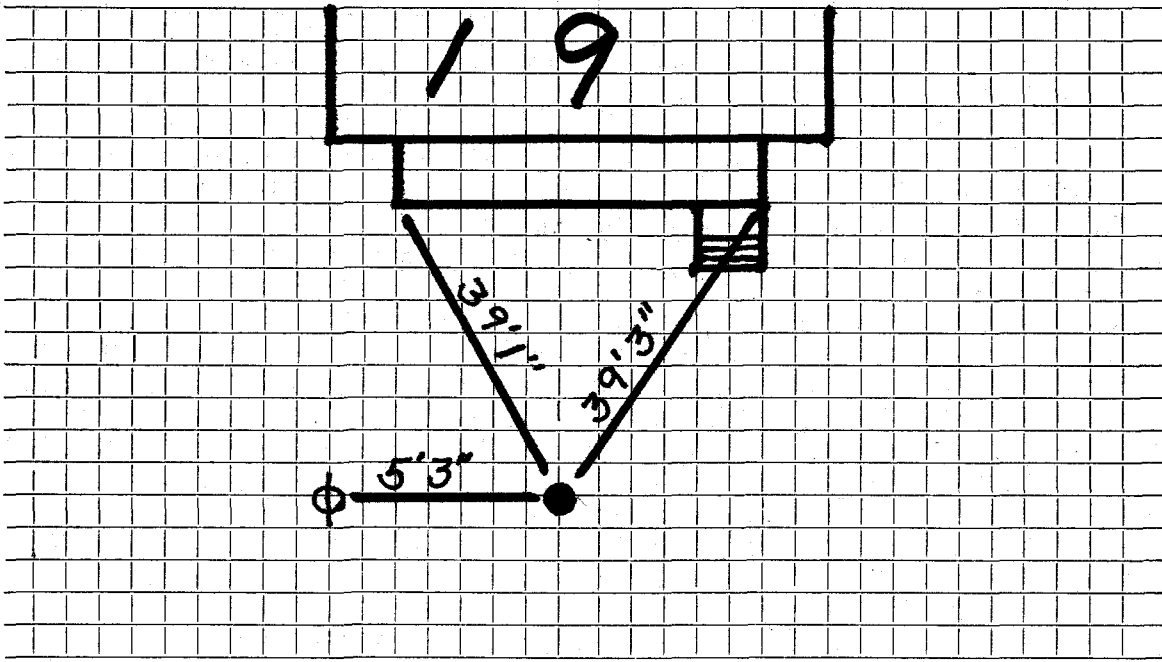

Connection made in Street. Work completed

Remarks:
.....
.....