

Name Mr. Michael J. Manley

Service No. ~~54~~ 2160

Address 20 Parker Street

2943

Location

Kind of Pipe

Size

Size of Main

~~Repairs-Renewal~~ - New Service (Renewal)

Location

Date	Material	Amount	Total	Date	Amount
11/10/34	47' 3/4" C. Pipe @.18	\$8 46		Dec. 11, 1934 - Cash	44 65
<i>11-27-34</i>	1 S & W	2 75			
	Trucking	75	\$11 96		
62	Hrs. Labor @.55	34 10			
2	" " @.60	1 20	35 30		
	10% overhead		3 53		
	COST		50 79		
	CHARGE - Estimated price, 47' @ .95,		\$44 65		
	Labor				

Key Press, Inc., Lexington

DATE _____

TOWN OF LEXINGTON—BOARD OF PUBLIC WORKS

WATER DIVISION

The undersigned applies for a supply of water at No. _____ St. and hereby agrees to comply with the rules and regulations as now, or at any future time, established by the Board of Selectmen.

Am't. of Estimate \$ _____


Owner _____

Am't. Paid \$ _____

Address _____

Builder _____

Sketch of Service Here

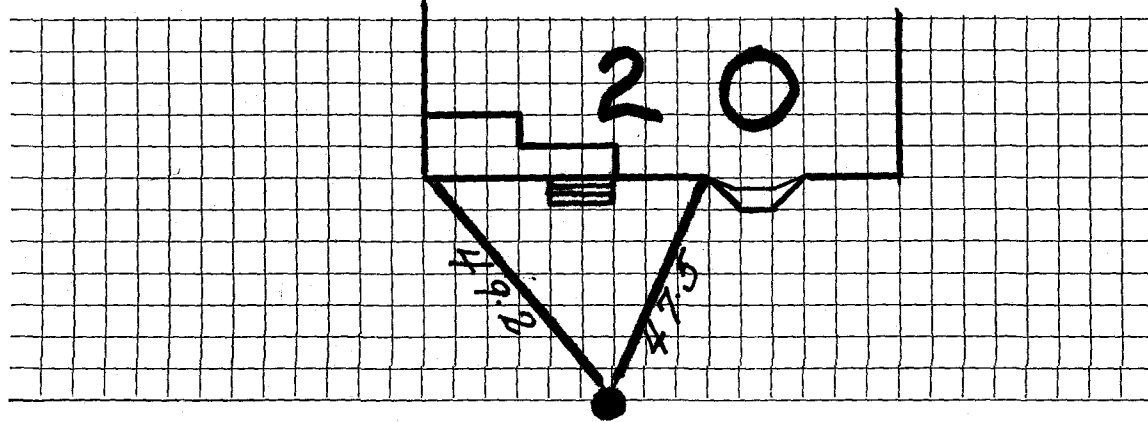

Connection made in _____ Street.

Work completed _____ 19

Remarks: