

Name

Service No. 2161

Address

919

Location 21 Parker St.

Kind of Pipe

Size

Size of Main

Repair—Renewal—New Service

Location

Date	Material	Amount	Total	Date	Amount
	Checked 6-23-94 Outside 3/4 Copper				
	Labor				

Hidley Press, Inc., Lexington

TOWN OF LEXINGTON—BOARD OF PUBLIC WORKS

WATER DIVISION

The undersigned applies for a supply of water at No. _____ St. and hereby agrees to comply with the rules and regulations as now, or at any future time, established by the Board of Selectmen.

Am't. of Estimate \$ _____

Owner

A. S. Washburn.


Am't. Paid \$ _____

Address

21. Parker St.

Builder _____

Sketch of Service Here

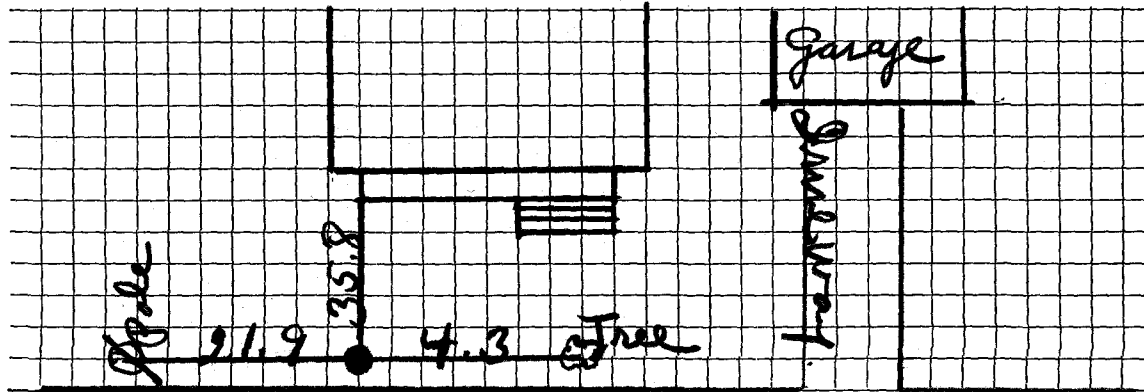

Connection made in Parker St. Street.

Work completed _____ 19

Remarks: