

Name Lexington Co-op. Bank

Service No. ~~10~~ 2162

Address Lexington, Mass.

#136

24 Parker St.

Location 24 Parker Street

Kind of Pipe

Size

Size of Main

Repair—Renewal—New Service

Location

Date	Material	Amount	Total	Date	Amount
June 27, '39	8 hrs. @ 50¢	4 00		July 26, 1939 Paid	29 49
<i>from 7-24-39</i>	8 " @ 55¢	4 40			
	11 " @ 60¢	6 60			
	3 " @ 65¢	1 95	16 95		
	Overhead				
	28' 3/4" Copper tubing @ 20¢		5 60		
	1 3/4" C S.& W.		3 75		
	2 hrs. Trucking @ 75¢		1 50		
			<u>\$ 29 49</u>	<i>Bill sent 7/20/39</i>	
	Labor				

Hadley Press, Inc., Lexington

DATE

June 21, 1934

TOWN OF LEXINGTON—BOARD OF PUBLIC WORKS

WATER DIVISION

The undersigned applies for a supply of water at No. *24 Parker* St. and hereby agrees to comply with the rules and regulations as now, or at any future time, established by the Board of Selectmen.

Am't. of Estimate \$ *42.00*

Owner


Lexington Coop. Bank

Am't. Paid \$ _____

Address

Builder _____

Sketch of Service Here

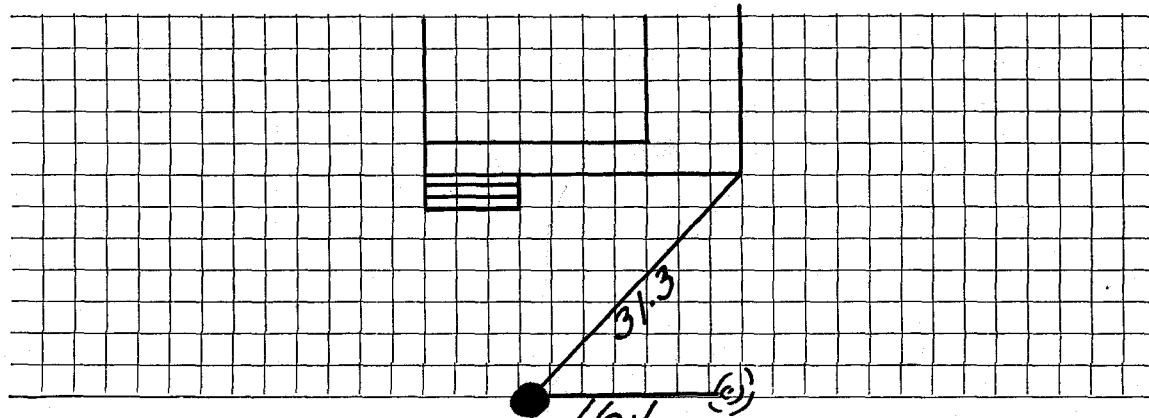

Connection made in _____ Street.

Work completed _____ 19

Remarks: