

WATER SERVICE RECORD

Name **R. A. Burnham**

Service No.

Address **25 Parker Street**

4643

Location

~~RENEWAL - WATER SERVICE~~

WO # **7555**

Comm **10-29-62**


Date	Material	Amount	Total	Date	Amount
8-21-62	Labor	15.30		8-20-62	Deposit 75.00
9-5-62	"	8.37	21.87	10-29-62	Refund 18.41
	10% O.H.		2.19		56.39
			24.06		
	40' 3/4" Copper tubing @42		16.80		
	1 3/4" CX1" C2 part Union		1.62		
	1 1" Close Brass Nipple		.76		
	1 Box & Rod		4.90		
	2 Hrs. Trucking @3.00		6.00		
	1/2 Hr. Compressor @3.00		.75		
	1/2 Ton Hot Top @6.00		1.50		
			56.39		

DATE _____

TOWN OF LEXINGTON — BOARD OF PUBLIC WORKS

WATER DIVISION

Sketch of Service Here

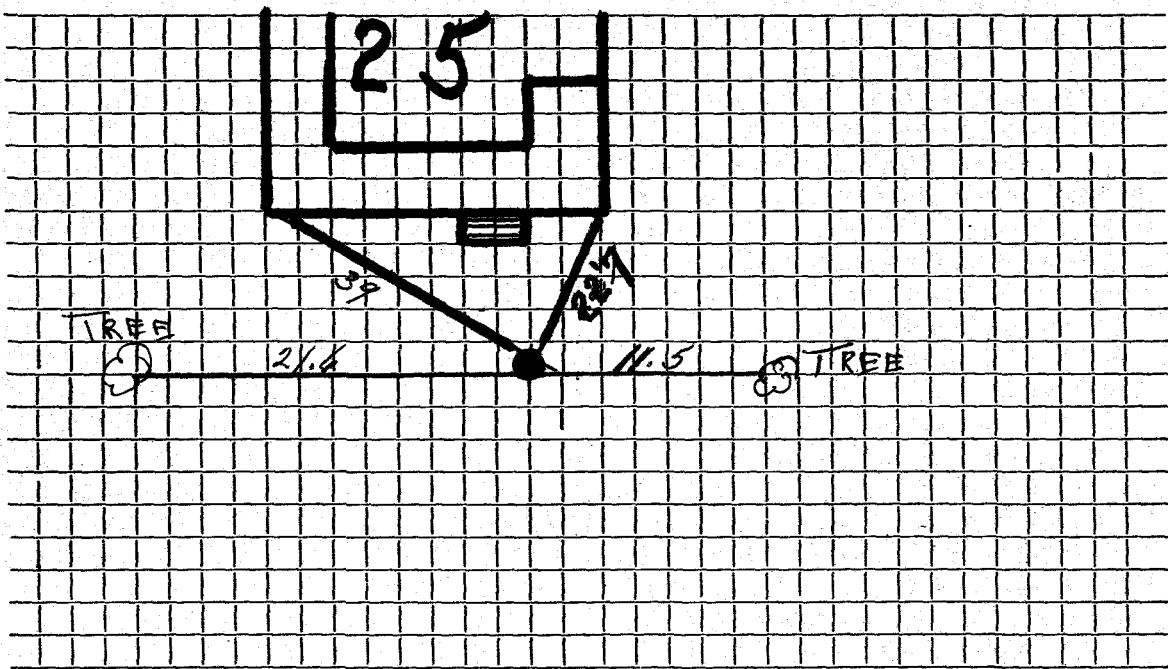

Connection made in Street. Work completed

Remarks: *old tie*

.....

.....