


TOWN OF LEXINGTON — BOARD OF PUBLIC WORKS

WATER DIVISION

Sketch of Service Here

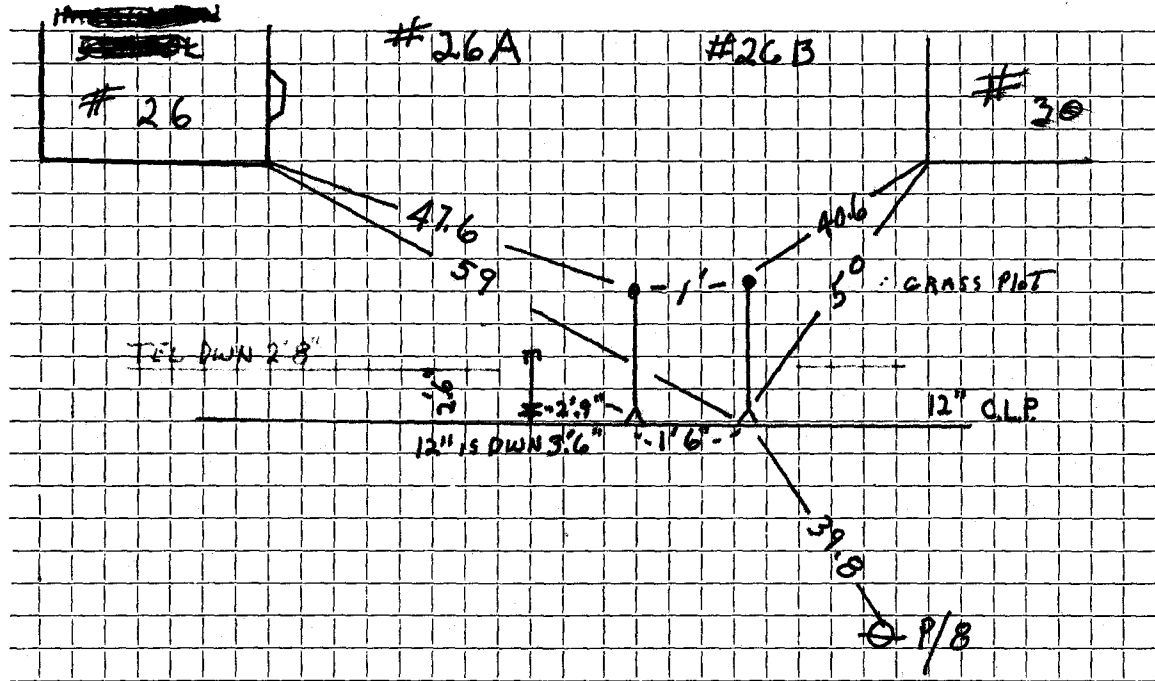

Connection made in Street. Work completed

Remarks: 6" D.I.P. 1.5 CAPED. 2" BRYOND TEL DUCT.