

Name I. J. Michelson

Service No. # 2166

Address 6 Jackson Court
29 Parker St.

3692

Location 29 Parker St.

Kind of Pipe

Size

Size of Main

~~Repair~~ ~~Renewal~~ - New Service

Location

Date	Material	Amount	Total	Date	Amount
Paid-10-28 for 7062	34' 1" C.L. Pipe @ .27	9 18			
	1 1" L.L. Coup. @ .25	25		Mar. 20 1928-	62 10
	2 1" L.L. Ells @ .30	60		Nov. 20 1928- Abate	852
	1 1" Br. Sp. Nipple	25			7062
	1 S & W	3 00		Outside	
	Trucking	75	14 03	Checked 7-5-94 - 3/4 Copper	
	Constr. charge		3 00		
3/29/28	79 Hours Labor @ .55	43 45			
	2 " " @ .60	1 20			
	3 " " @ .65	1 95	46 60		
	15% Overhead		6 99		
	Labor NOTE:		70 62		
	Labor for water &				
	sewer services on this slip				

Hadley Press, Inc Lexington

7062
1200
8352

DATE 3/20/20

TOWN OF LEXINGTON—BOARD OF PUBLIC WORKS

WATER DIVISION

The undersigned applies for a supply of water at No. 29 Tucker St. and hereby agrees to comply with the rules and regulations as now, or at any future time, established by the Board of Selectmen.

Am't. of Estimate \$ 10⁰⁰

Owner J. A. Michels


Am't. Paid \$ _____

Address _____

Builder D. A. Gorman

in same trench with sewer

Sketch of Service Here

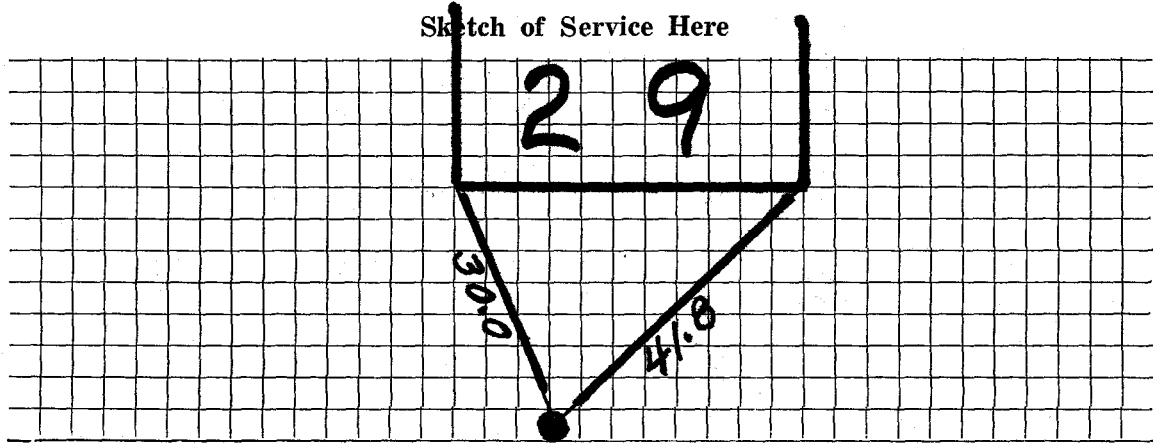

Connection made in _____ Street.

Work completed _____ 19

Remarks: