

WATER SERVICE RECORD

Name *Bob Earsy*

Service No.

Address *32 Parker Street*

Location

Repair—~~Renewal~~—New Service
~~XXXXXXXXXXXXXXXXXXXX~~ Arlex #4518


Date		Material		Amount		Total		Date		Amount	
5/8/84		18' 1" Copper									
	1	Valve									
OUTSIDE											
							5/8/84	23'	1" Copper Tubing		
									1" Corp.		
									1" Curb		
									Box & Rod		

DATE _____

TOWN OF LEXINGTON — BOARD OF PUBLIC WORKS

WATER DIVISION

Sketch of Service Here

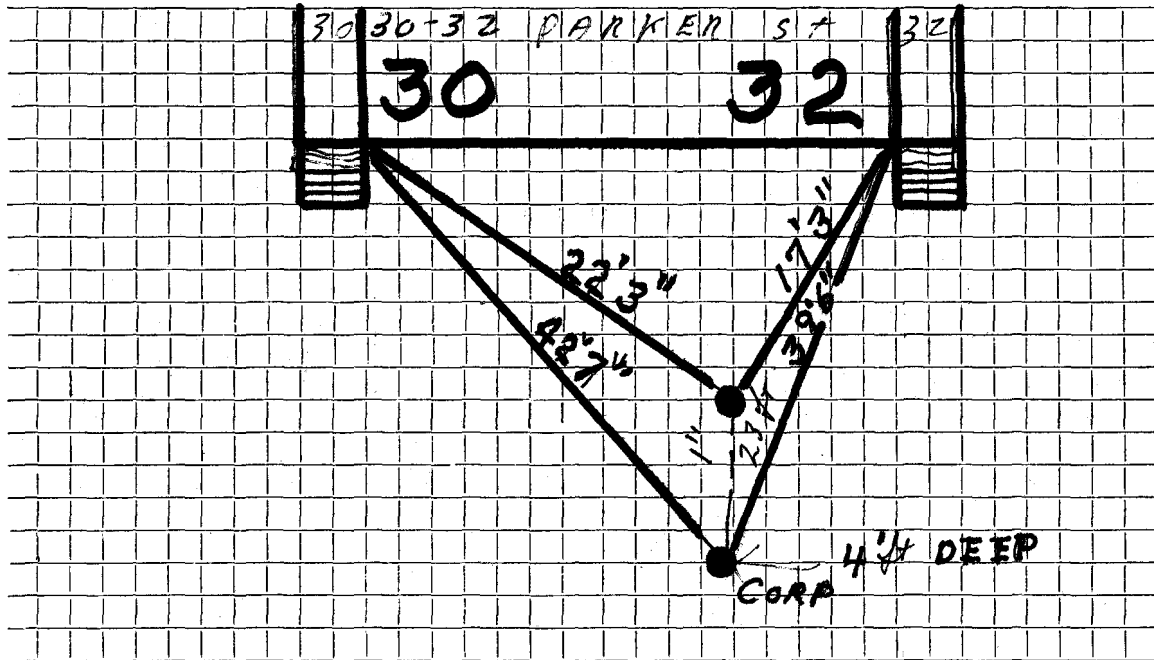

Connection made in Street. Work completed

Remarks:

.....

.....