



DATE _____

TOWN OF LEXINGTON — BOARD OF PUBLIC WORKS

WATER DIVISION

33 Parker

Sketch of Service Here

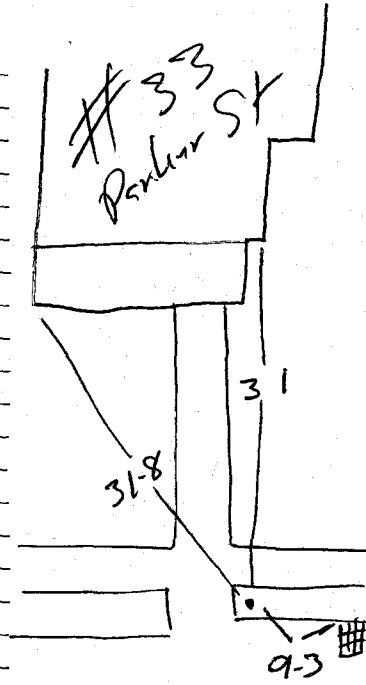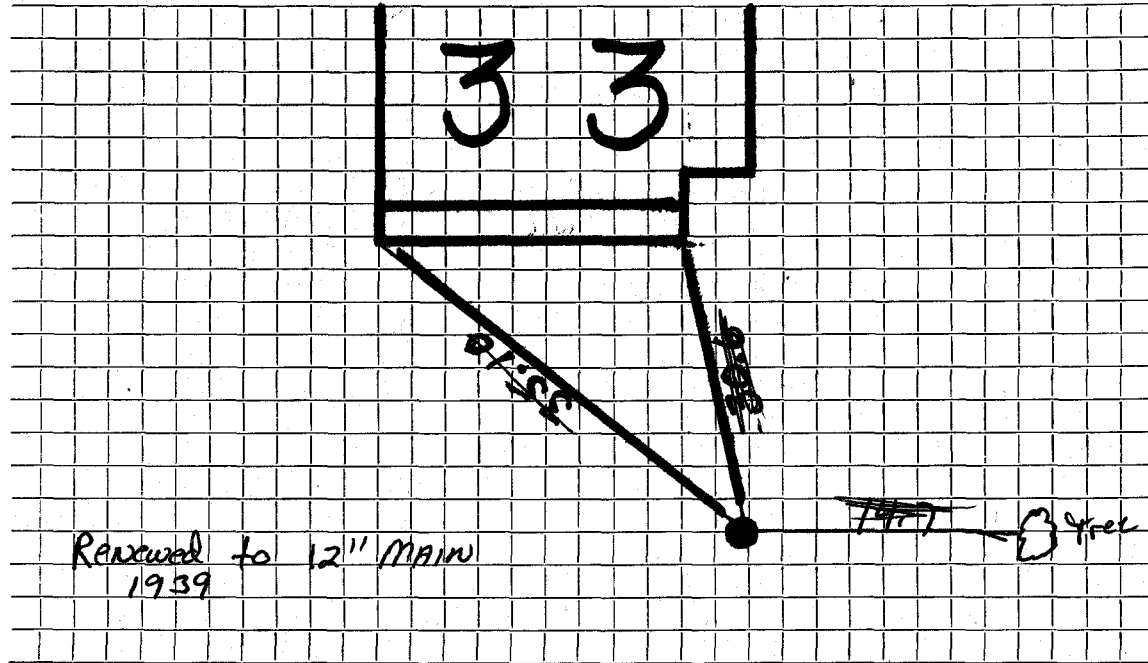

Connection made in Street. Work completed

Remarks:

.....

.....