

WATER SERVICE RECORD

Name *George Haynes*

Service No.

Address *35 Parker Street*

Location

Repair ~~Renewal~~ ~~New Service~~ *W.O. #345*


Date	Material	Amount	Total	Date	Amount
<i>12/30/82</i>	<i>Labor</i>	<i>\$16.76</i>		<i>2-25-83</i>	<i>Paid</i>
	<i>10% O.H.</i>	<i>1.68</i>	<i>\$18.44</i>		
<i>22'</i>	<i>3/4" Copper tubing @.85</i>		<i>18.70</i>		
<i>1</i>	<i>3/4" Wheel Stop</i>		<i>23.50</i>		<i>OUTSIDE</i>
			<i>\$60.64</i>	<i>12/30/83</i>	<i>5' 3/4" Copper tubing</i>
	<i>Bill sent 1-18-83</i>				<i>1 1" x 1" Brass Nipple</i>
					<i>1 Box & Rod</i>
					<i>1 1" Copper to Iron Coupling</i>

DATE _____

TOWN OF LEXINGTON — BOARD OF PUBLIC WORKS

WATER DIVISION

Sketch of Service Here

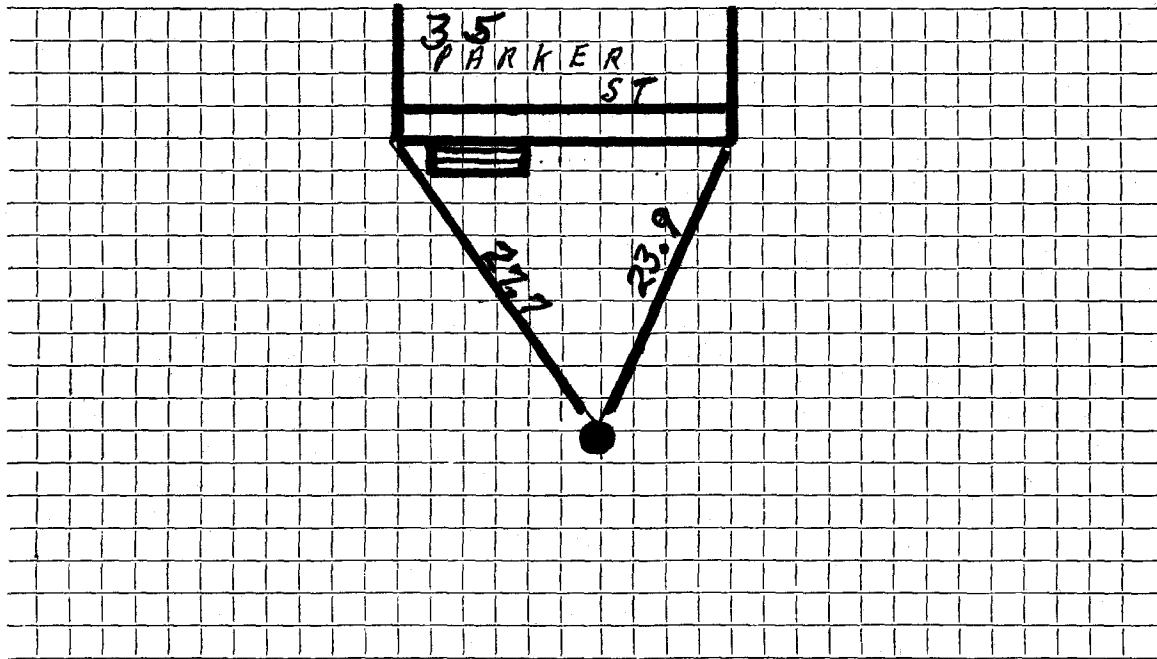

Connection made in Street. Work completed

Remarks: *about 25' 3/4" COPPER OUTSIDE*
27' 3/4" COPPER INSIDE