

WATER SERVICE RECORD

#5290

Name KKathryn H. von Stetten

Service No. 47

Address 40 Parker Street -

Location

~~Repair~~—Renewal—~~New Service~~ W. O. # 9985

DEC 18 1972


Date		Material	Amount		Total	Date	Amount
8/9/72		Labor	73	96		8-9-72	135 00
8/10.72		"	11	84		12-18-72	18 92
		10% O.H.	8	58	94		156 08
	35'	3/4" Copper pipe .79			27		
	1	1" Iron to copper fitting			4		
	1/2	Ton Hot top 8.00			2		
	1	Hr. Truck			3		
	2	Hrs. Shovel 6.50			13		
	1	Wheel Handle			12		
					156		

DATE _____

TOWN OF LEXINGTON — BOARD OF PUBLIC WORKS

WATER DIVISION

Sketch of Service Here

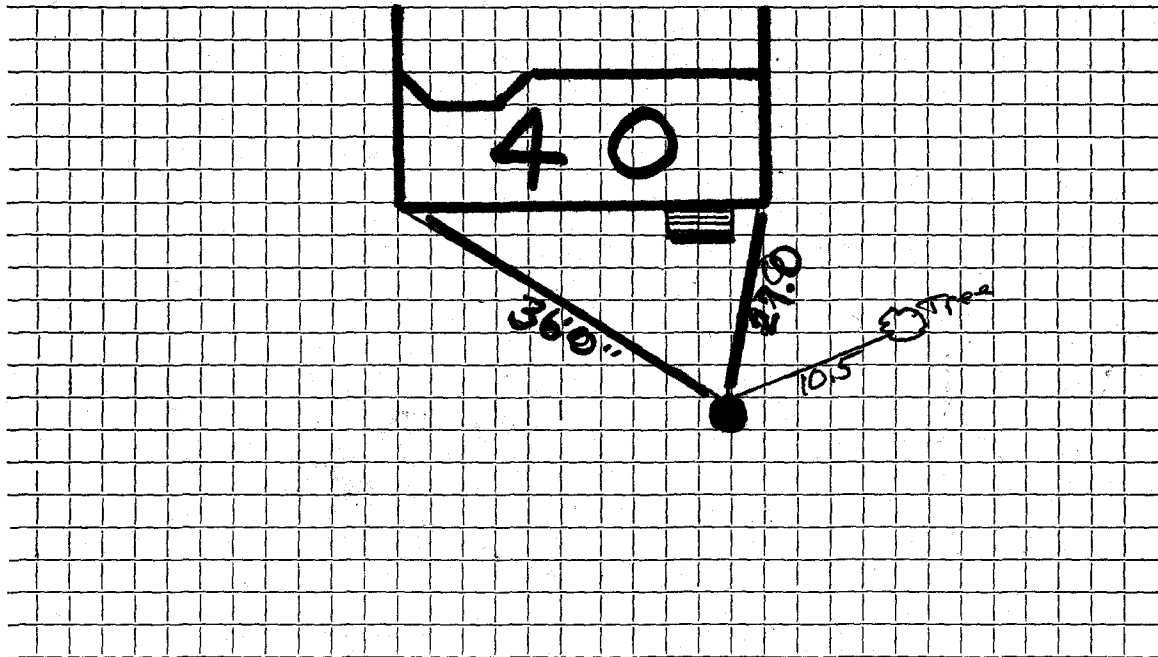

Connection made in Street. Work completed

Remarks:
.....
.....