

Name Mrs. Nellie McGrory

Service No. ~~85~~ 2174

Address 44 Parker St., Lexington,

530

Location 44 + 46 Parker St.

Kind of Pipe

Size

Size of Main

~~Repair~~—Renewal—New Service

Location

Date 1941	Material	Amount	Total	Date	Location	Amount
Aug. 6 <i>from 8/24/41</i>	4 hrs. @ 60¢	2 40		August 8, 1941	Deposited	16 00
	10% Overhead	<u>24</u>	2 64	August 20, 1941	Refunded	<u>2 37</u>
	31' 3/4" Copper tubing @ 19¢.		5 89			13 63
	1 3/4" c. xI Union		60			
	1 3/4" C. x 1/2" I S. & W.		2 25			
	3 hrs. trucking @ 75¢		<u>2 25</u>			
			13 63			
	Labor					

Hadley Press, Inc., Lexington

DATE _____

TOWN OF LEXINGTON—BOARD OF PUBLIC WORKS

WATER DIVISION

The undersigned applies for a supply of water at No. _____ St. and hereby agrees to comply with the rules and regulations as now, or at any future time, established by the Board of Selectmen.

Am't. of Estimate \$ _____


Owner _____

Am't. Paid \$ _____

Address _____

Builder _____

Sketch of Service Here

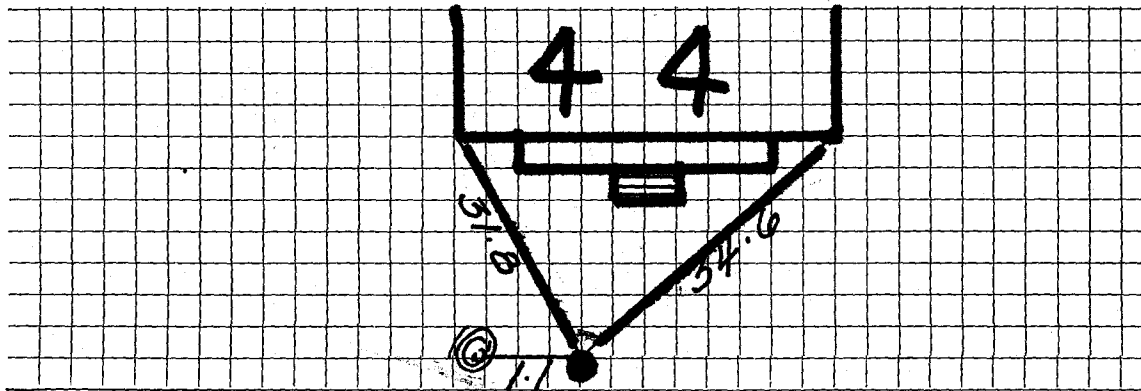

Connection made in _____ Street.

Work completed _____ 19

Remarks: