

WATER SERVICE RECORD

Name Elizabeth Collins

Service No. 29

Address 48 Parker Street

Location

~~REPAIR~~—Renewal—~~REPAIR~~

W.O. # 2529

FEB 10 1975


Date	Material	Amount	Total	Date	Amount	
9-18-74	Labor	87 96		9-16-74	Deposit	250 00
	10% O.H.	8 80	96 76	2-10-75	Retard	85 64
	30' Copper Pipe @ 1.05		31 50			164 34
	1 3/4" Wheel Valve		11 13		<u>Non-Charge Work</u>	
	1 Yd. Loam		5 00	10-2-74	Labor	11 02
	1 Lb. Grass Seed		95		1 Hr. Trucking	3 00
	2 Hrs. Trucking	3 00	6 00		1 Hr. Trucking (Pick-UP)	1 50
	2 Hrs. Town Shovel	6 50	13 00		1 Hr. Loader	4 00
			\$164 34		1 Hr. Compressor	5 00
					1 Patch 8'x5'	35 52
						\$60 04

DATE _____

TOWN OF LEXINGTON — BOARD OF PUBLIC WORKS

WATER DIVISION

Sketch of Service Here

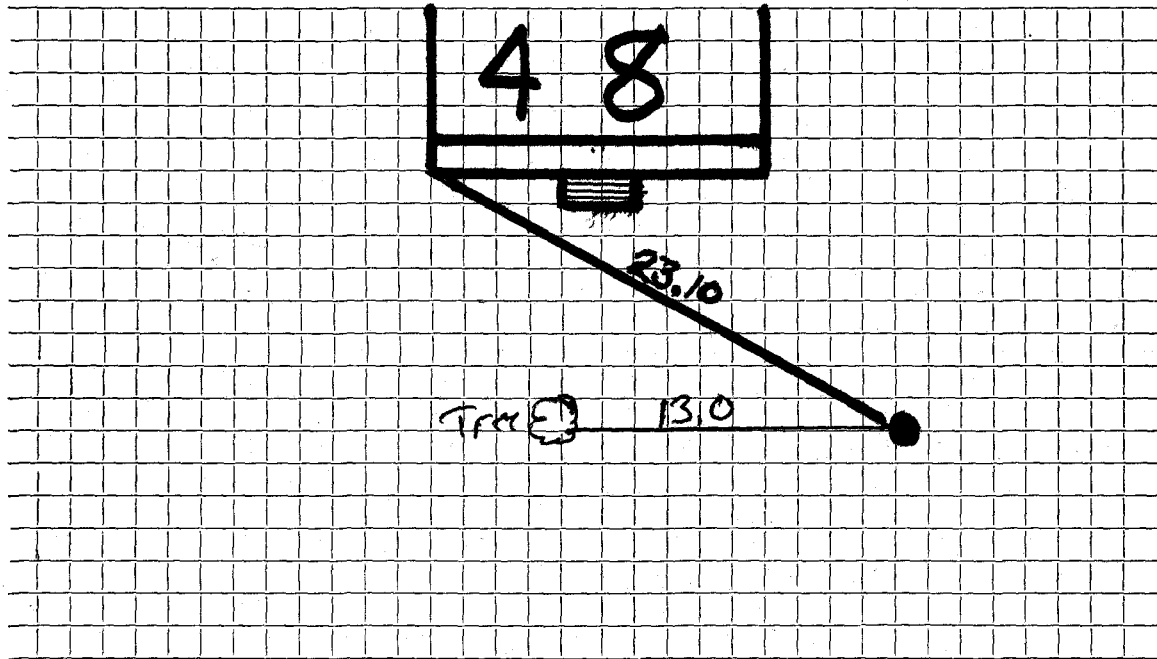

Connection made in Street. Work completed

Remarks:
.....
.....