


DATE 9-15-190

TOWN OF LEXINGTON — BOARD OF PUBLIC WORKS

WATER DIVISION

Sketch of Service Here

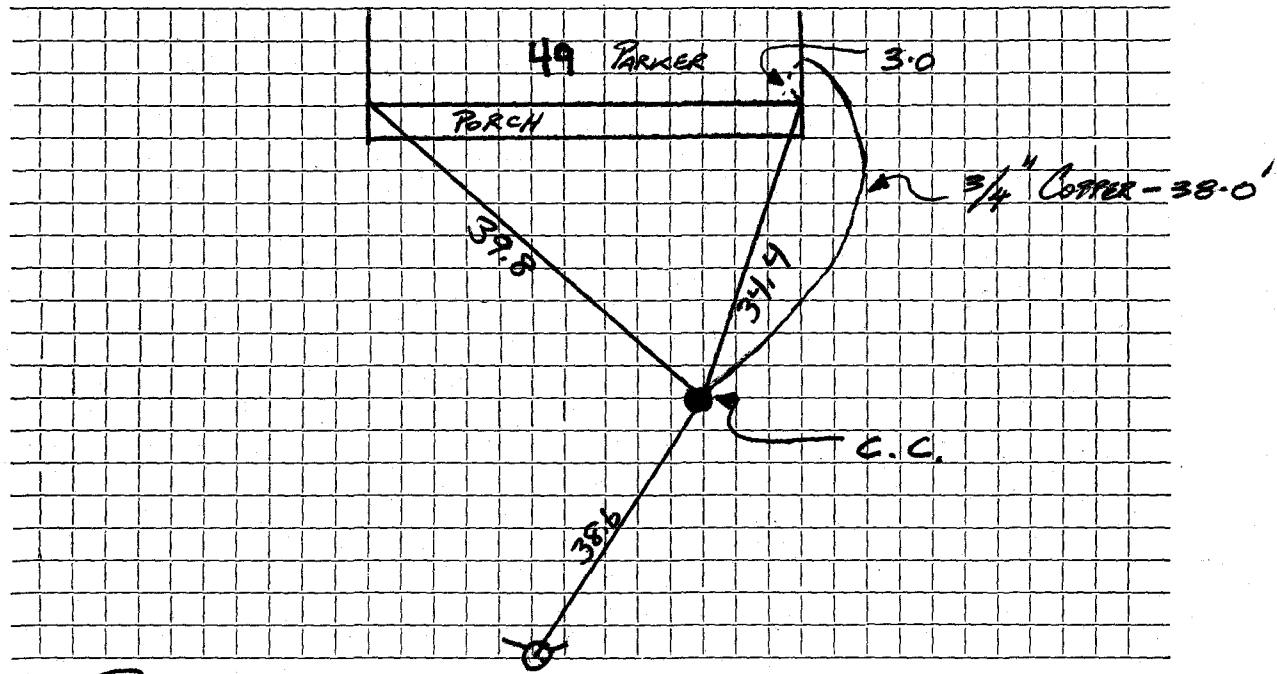

Connection made in PARKER Street. Work completed

Remarks:
.....
.....