

WATER SERVICE RECORD

Name Robert J. Marotto

Service No. 4

Address 5 Parker St.

Location

AUG 8 1977

~~Repair~~—Renewal—~~New Service~~


Date		Material	Amount		Total	Date	Amount	
3/25/77		labor	100.	26		3/24/77	Deposit	350.00
		10%OH	10.	02	110.28	8/8/77	Refund	126.79
	35'	3/4 copper @ .65			22.75			223.21
	1	3/4 wheel handle			15.98		OUTSIDE	
	1	3/4 X 1/2 reducing bushing			1.46	3/25/77	Patch 14 X 5	
	1	3/4 X 3/4 male adapter			3.62			
	1	hrs. trucking			3.00			
	3	hrs. town shovel @ 6.50			19.50			
		hot top			46.62			
					223.21			

DATE _____

TOWN OF LEXINGTON -- BOARD OF PUBLIC WORKS

WATER DIVISION

Sketch of Service Here

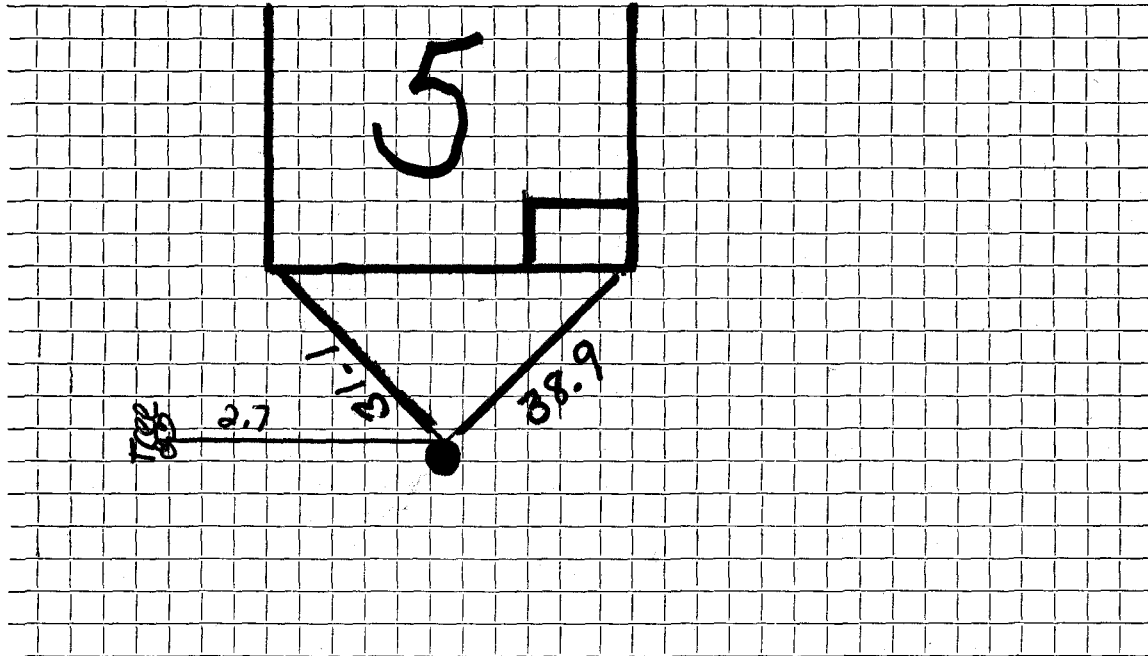

Connection made in Street. Work completed

Remarks:

.....
.....