

WATER SERVICE RECORD

#5247

Name Thomas Murray

Service No. 133

Address ~~100 [redacted]~~ 50 Parker Street ~~[redacted]~~

Location

~~Repair [redacted] - Max [redacted]~~ RENEWAL

Comm. 9/30/57

Date	Material	Amount	Total	Date	Amount
7/15/57	Labor	26 68		7-15-57	# 75 00
	10% overhead	2 67	29 35	9-30-57	26 12
	30' - 3/4" Copper tubing @ .375		11 25		# 48 58
	1 - 3/4" x 1/2" I.W.H. Stop & Waste		4 96	1 - 1/2"	50
	1 - 3/4" C. Union; (3 part)		2 27	1 - 1/2"	50
	1 hr. Trucking		75		1 00
			48 58		

Deposit

Refund

NON CHARGE


Straight tailpiece

Offset tailpiece

DATE \_\_\_\_\_

**TOWN OF LEXINGTON — BOARD OF PUBLIC WORKS**  
**WATER DIVISION**

Sketch of Service Here

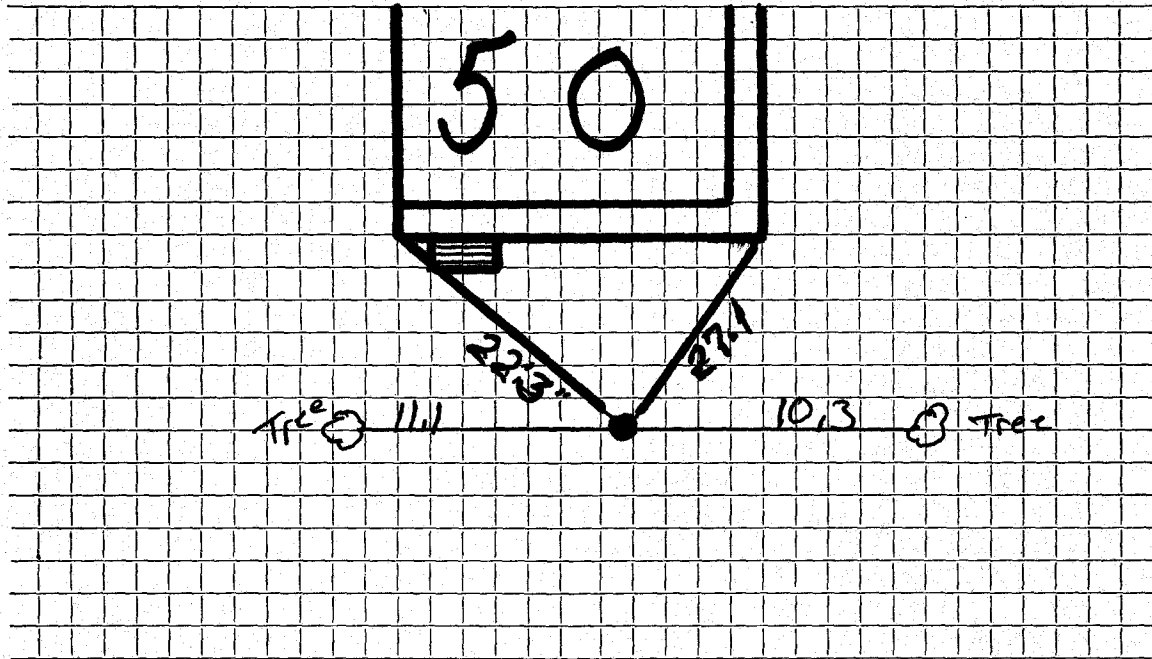

Connection made in ..... Street. Work completed .....

Remarks: .....  
.....  
.....