

Name Arthur W. Freeman

Service No. ~~21~~

2152

Address 6 Parker St.

3545

Location Same

Kind of Pipe

Size

Size of Main

~~Repair~~—Renewal—~~New Service~~

Location

Date	Material	Amount	Total	Date	Amount
Aug. 12-14 <i>Comp. 1.70.00 to Russell 9/1/35</i>	22½ hrs. @ 50¢	11 25		<i>Aug. 16, 1935 - Deposited</i>	30 00
	22½ " @ 55¢	12 38			
	1 hr. @ 60¢	60			
	10% Overhd. on labor	2 42			
	30' ¾" Copper pipe @ 16¢	4 80			
	1 ¾" S. & W.	1 75			
		<u>\$33 20</u>			
	Note: Part of time for excavation in street, say 30 ft. @ \$1.00 =		<u>\$30 00</u>		
	Labor				

Hadley Press, Inc., Lexington

30 ft.
DATE August 12, 1935

TOWN OF LEXINGTON—BOARD OF PUBLIC WORKS

WATER DIVISION

The undersigned applies for a supply of water at No. 6 Parker St. and hereby agrees to comply with the rules and regulations as now, or at any future time, established by the Board of Selectmen.

Am't. of Estimate \$ 30.00

Owner

Arthur W. Freeman


Am't. Paid \$ _____

Address

6 Parker St

Builder _____

Sketch of Service Here

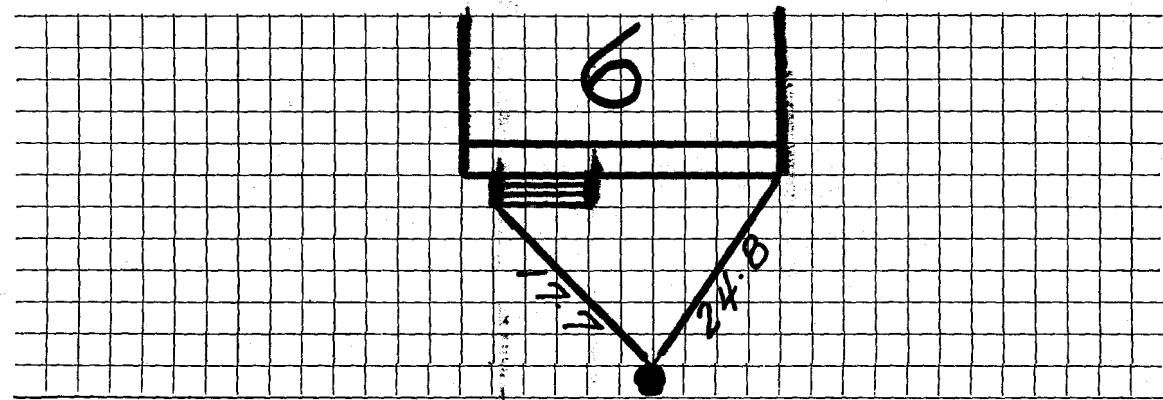

Connection made in _____ Street.

Work completed _____ 19

Remarks: