

## WATER SERVICE RECORD

2136 #6523  
Service No. 31

Name Raymond Harrington

Address 8 Parker Street

Location

~~RENEWAL~~—Renewal—~~W.O.#~~ W.O.#7910


Comm 8-26-63

Date	Material	Amount	Total	Date	Amount
5-20-63	Labor	32.28		5-10-63	Deposit 100 00
	10% O.H.	3.53	38.81	8-26-63	Refund 27 92
30'	3/4" Copper tubing @.42		12.60		72 08
1	3/4" C x 1/2 I.W.H. Stop & Waste		6.17		
5 x 3	Patch		5.00		
1	hr. Town Shovel @6.50		6.50		
1	hr. Trucking @3.00		<u>3.00</u>		
			72.08		

# TOWN OF LEXINGTON — BOARD OF PUBLIC WORKS

## WATER DIVISION

Sketch of Service Here

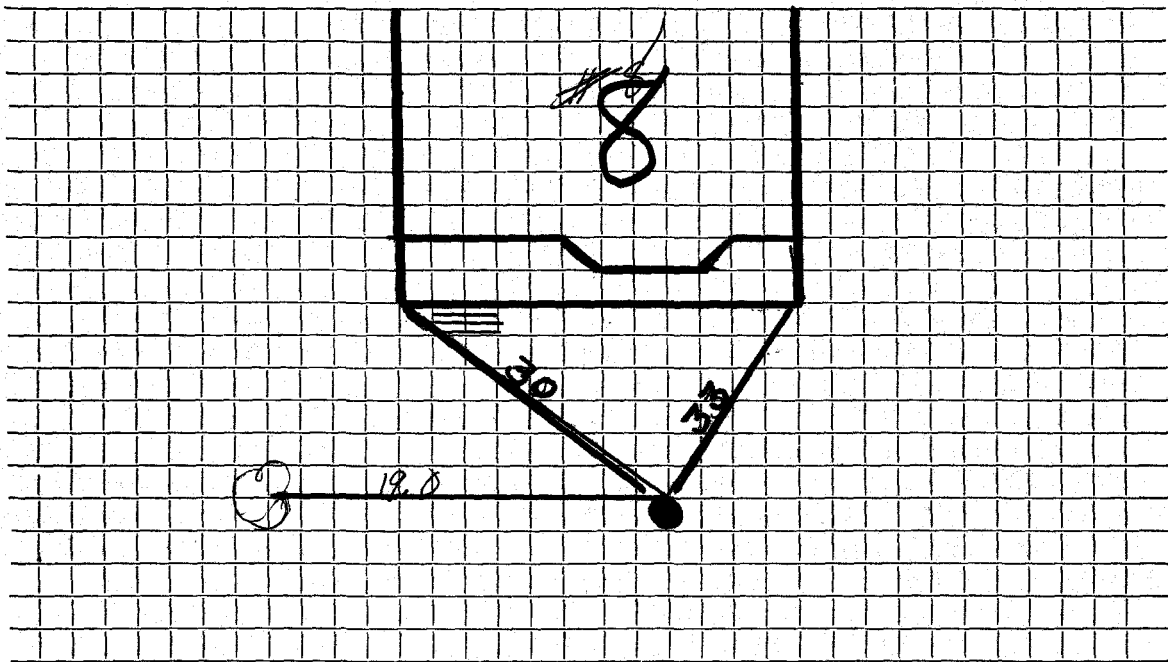

Connection made in ..... Street. Work completed .....

Remarks: .....  
.....  
.....