

## WATER SERVICE RECORD

Name Frank A. Yeomans

Service No. 62

Address 9 Parker Street

# 7490

Location

~~Repair~~ ~~Renewal~~ New Service

Commenced 9/3/57


Date	Material	Amount	Total	Date	Amount
4/15/57	Labor	2 15		4-10-57	Deposit \$ 50 00
	10% overhead	22	2 37	9-3-57	Refund \$ 23 74
	43' - 3/4" Copper tubing @ .4228	18 18			NON CHARGE # 2.6 26
	1 - 3/4" Cx $\frac{1}{2}$ I.W.H. Stop & Waste	4 96			
	1 hr. trucking		75		
			26 26		
				9 - 3/4" Copper tubing @ .4228	3 80
				1 - 3/4" O. Corp Cock	4 64
				1 - 3/4" O. Curb Cock	5 94
				1 Box & Rod	4 62
				1 - $\frac{1}{2}$ " Straight tailpiece	50
				1 - $\frac{1}{8}$ " Offset tailpiece	50
					<u>22 15</u>
				* Applied to S.H.C. # 40	
				7-19-73	Renewal
					18' $\frac{3}{4}$ " Copper
					1 $\frac{3}{4}$ " - 3 Part Union
					1 $\frac{3}{4}$ " Corp.

DATE \_\_\_\_\_

TOWN OF LEXINGTON — BOARD OF PUBLIC WORKS

**WATER DIVISION**

Sketch of Service Here

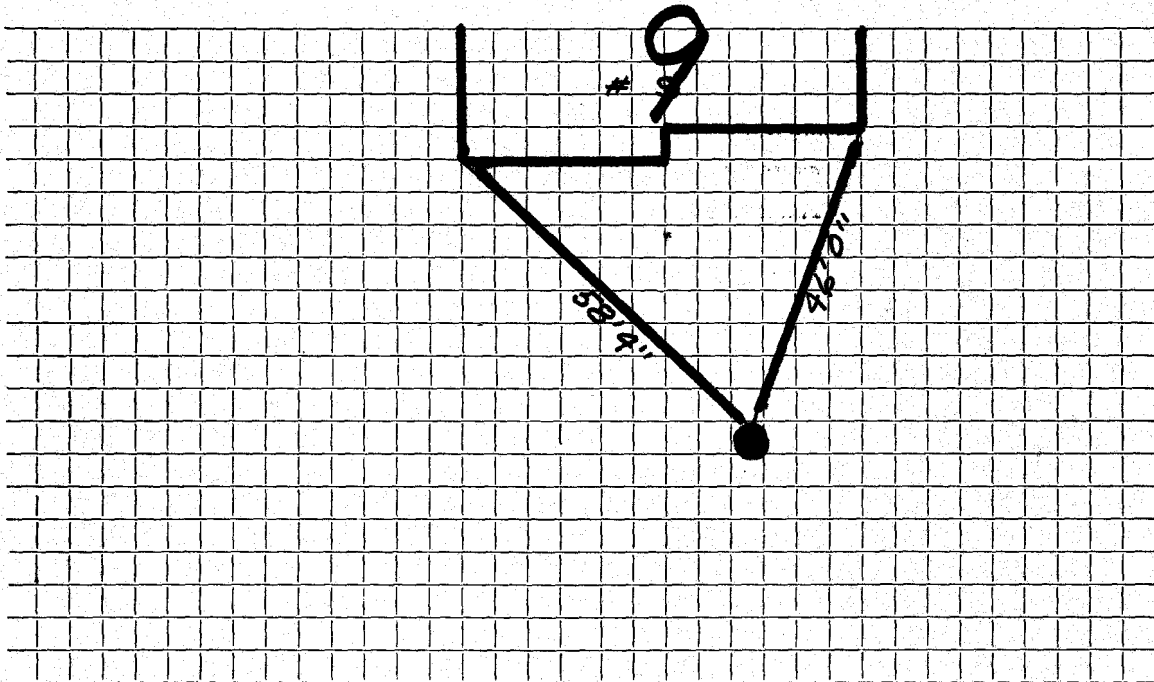

Connection made in ..... Street. Work completed .....

Remarks: .....

.....

.....