

WATER SERVICE RECORD

Name Holiday Homes, Inc.

Service No. 38

Address 11 Partridge Road

2226

Location Lot #87 Sta 7/72

~~REPAIR~~ New Service

Wc # 795/

Comm 6-3-63


Date	Material	Amount	Total	Date	Amount
5-20-63	Labor	5.74		5-17-63	Deposit 12.50
	10% O.H.	.57	6.31	6-3-63	ReFund 79.81
	65' 3/4" Copper tubing @.42		27.30		45.19
1	3/4" C x 1/2 I.W.H. Stop & Waste		6.17		NON CHARGE
1	3/4" C 3 part union		2.41	8/1/61	Labor 8 19
1	hr. Trucking @3.00		3.00	26'	3/4" Copper tub. @.42 10 92
			45.19	1	3/4" C Corp Cock 4 91
				1	3/4" C Curb Cock 6 28
				1	Box & Rod 4 90
					35 20

DATE _____

TOWN OF LEXINGTON — BOARD OF PUBLIC WORKS

WATER DIVISION

Sketch of Service Here

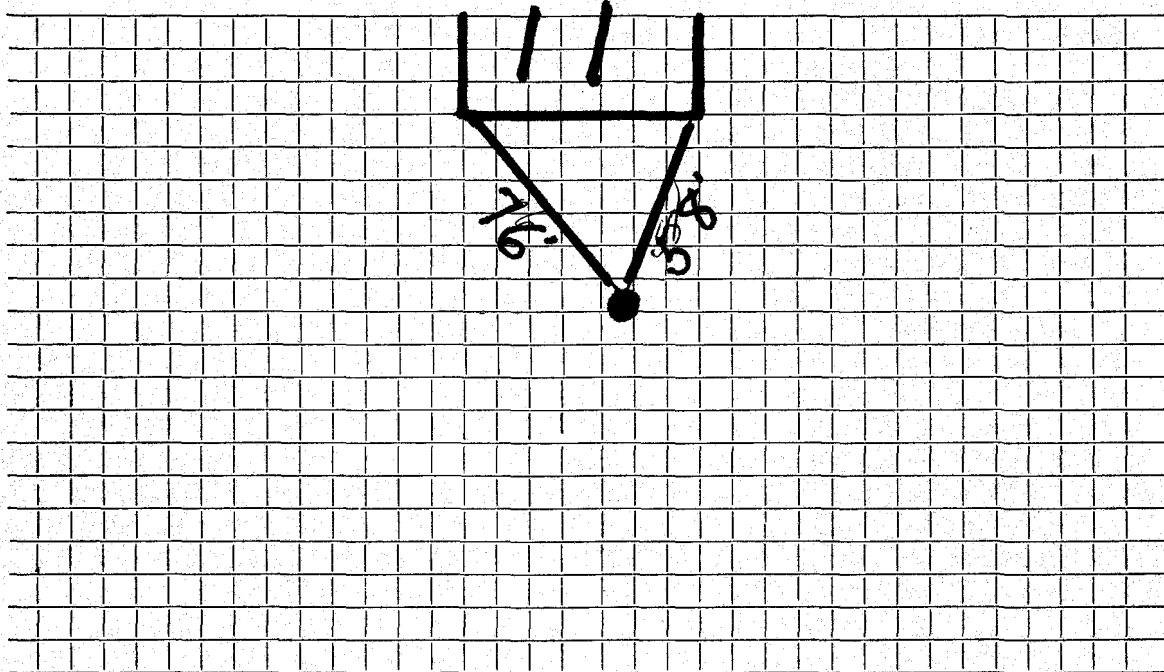

Connection made in Street. Work completed

Remarks:
.....
.....