

WATER SERVICE RECORD

Name Holiday Homes, Inc.

Service No. 72

Address 10 Partridge Road

Location Lot #64 Sta 7/26

Repair ~~ORDER~~ New Service W.O.# 7351

Comm 10-1-62

Date	Material	Amount	Total	Date	Amount
8/2/61	Labor	3 78		6-12-62	Deposit 25 00
	10% O.H.	38	4 16	10-2-62	25 58
	12' 3/4" Copper tubing @.42		5 04		100 58
	1 Hr. Trucking @3.00		3 00		
	BILL WHEN CONNECTED		12 20	8/2/61	Labor 2 84
6/20/62	Labor	24 00		9'	3/4" Copper Tubing @.42 3 78
	10% O.H.	2 40	26 40	1	3/4" C Corp Cock 4 91
	120' 3/4" Copper Tubing @ .42		50 40	1	3/4" C Curb Cock 6 28
	1 3/4" Cx 1/2 IWH Stop & Waste		6 17	1	Box & Rod 4 90
	1 3/4" C3 Part Union		2 41		22 71
	1 Hr. Trucking @ 3.00		3 00		
			100 58		


Bill sent 2558

DATE \_\_\_\_\_

TOWN OF LEXINGTON — BOARD OF PUBLIC WORKS

WATER DIVISION

Sketch of Service Here

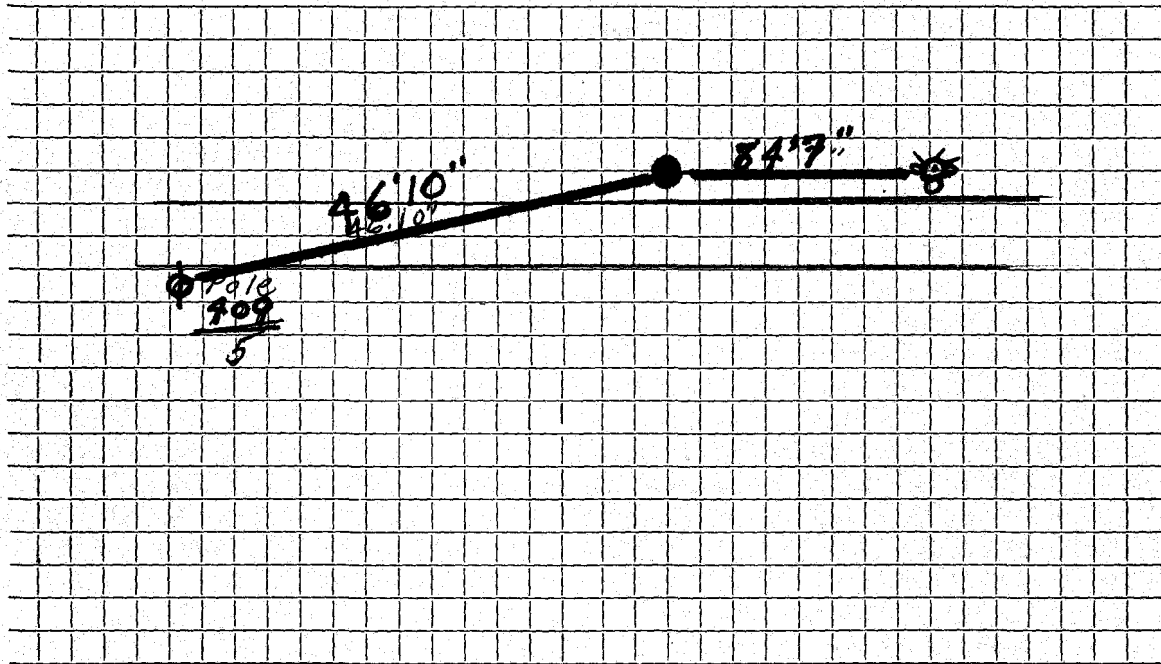

Connection made in ..... Street. Work completed .....

Remarks: .....  
.....  
.....