

## WATER SERVICE RECORD

Name Holiday Homes, Inc.

Service No. 145

Address 12 Partridge Road # 3446

Location Lot #65 Sta 8/85

~~REPAIR WORK~~ New Service


WO # 7622

Comm 12-10-62

Date	Material	Amount	Total	Date	Amount
7/28/61	Labor	4 10		10-18-62	Deposit 25 00
	10% O.H.	41	4 51	12-28-62	33 86
	13' 3/4" Copper tubing @.42		5 46		108 86
	1 Hr. Trucking @3.00		3 00		
	BILL WHEN CONNECTED		12 97	7/28/61	Labor 2 21
10-19-62	Labor	16.90		7'	3/4" Copper tubing @.42 2 94
	10% O.H.	1.69	18.59	1	3/4" C Corp Cock 4 91
145'	3/4" Copper tubing @.42		60.90	1	3/4" C Curb Cock 6 28
1	3/4" CX 1/2 I.W.H. Stop & Waste		6.17	1	Box & Rod 4 90
3	3/4" C3 Part Union @2.41		7.23		21 24
1	Hr. Trucking @3.00		3.00	10/19/62	1 1/2 Straight Tailpiece 50
			108.86	1	1/2 Offset Tailpiece 50
					22.24

TOWN OF LEXINGTON — BOARD OF PUBLIC WORKS  
WATER DIVISION

Sketch of Service Here

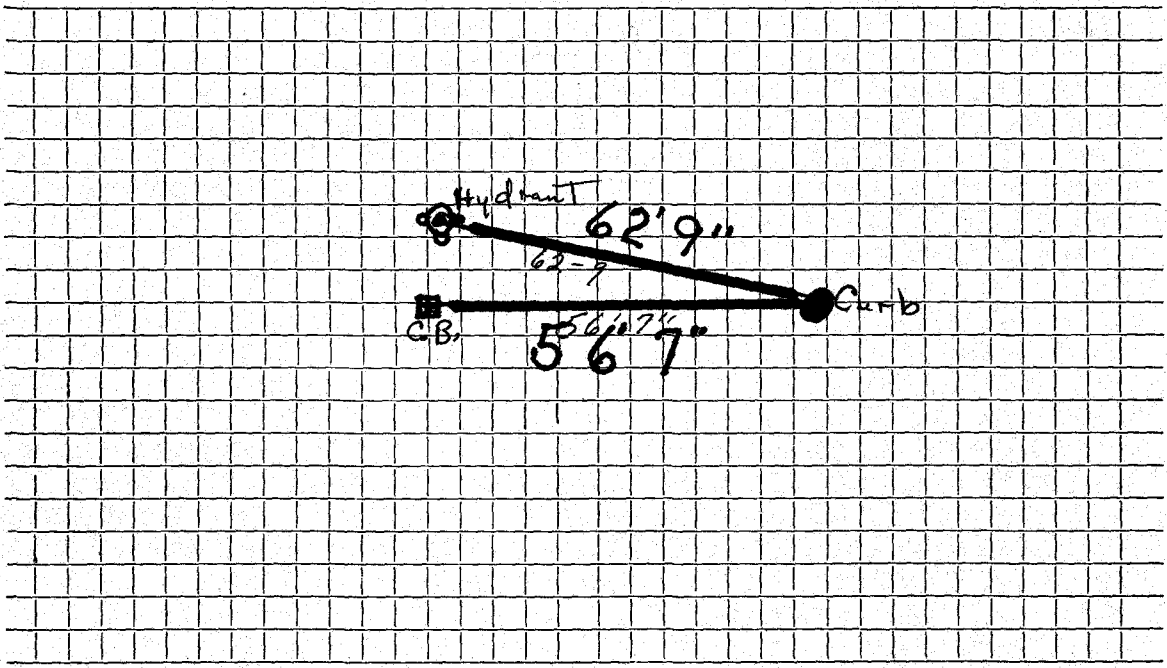

Connection made in ..... Street. Work completed .....

Remarks: .....  
.....  
.....