

## WATER SERVICE RECORD

Name Craig C. Hill (SWIMMING POOL)

Service No. 60

Address 13 Partridge Road

Location Lot #86 Sta. 9+10

Remarks: ~~Renewal~~ - New Service WO #7305

Comm 7-16-62


Date	Material	Amount	Total	Date	Amount	
6-7-62	Labor	39.42		5-21-62	Deposit	300.00
6-8-62	"	50.17	89.59	8-2-62		80.89
	10 % O.H.	8.96	98.55			380.89
45'	2" Copper tubing @1.28		57.60		NON CHARGE	
21'	2" Copper to owner @1.28		26.88	24'	2" Copper tubing @1.28	30.72
1	2" W.H. Stop & Waste		14.75	1	2" Corp Cock	24.13
1	2" 90° Brass Elbow		2.12	1	2" O.R. Seal Curb	40.84
1	2" C to I Female Adapter		9.16	1	Road Box	12.10
3	2 x 4 Brass Nipples @1.17		3.51	1	8 x 2 Service Saddle	10.03
22	3 Patch		22.00	1½	hr. Town Shovel @6.50	9.75
1½	hrs. Town Shovel @6.50		9.75			127.57
2	hrs. Trucking @3.00		6.00			
1	hr. Loader @3.00		3.00			
			253.32			
	Curb to Main charged also		127.57			
			380.89			

DATE \_\_\_\_\_

TOWN OF LEXINGTON — BOARD OF PUBLIC WORKS

**WATER DIVISION**

Sketch of Service Here

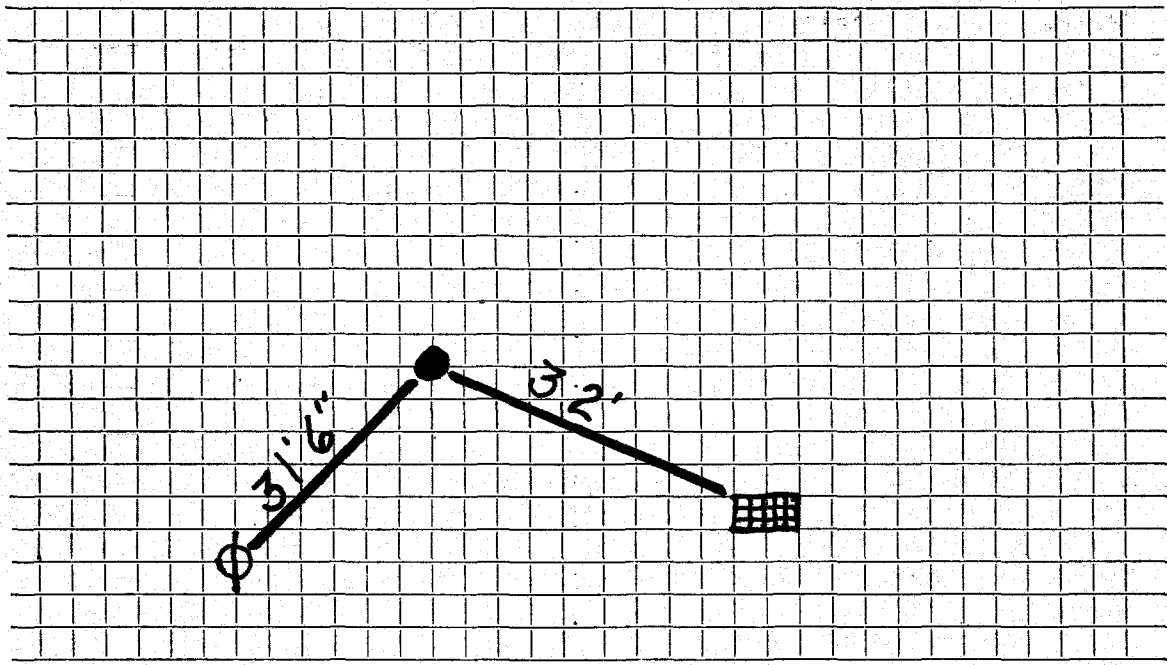

Connection made in ..... Street.      Work completed .....

Remarks: .....  
.....  
.....