

WATER SERVICE RECORD

Name Holiday Homes, Inc.

Service No. 11

Address 14 Partridge Road

Location Lot #66 Sta 10/56

~~REPAIR WORK~~ New Service WO# 7821


Comm 5-27-63

Date	Material	Amount	Total	Date	Material	Amount
7/28/61	Labor	4 41		4-5-63	Deposit	200 00
	10% O.H.	44	4 85	5-27-63	Refund	96 92
14'	3/4" Copper tubing @ .42		5 88			103 08
1	Hr. Trucking @ 3.00		3 00			
	BILL WHEN CONNECTED		13 73	7/28/61	Labor	2 21
4/11/63	Labor	5 74		7'	3/4" Copper tubing @ .42	2 94
	10% O.H.	57	6 31	1	3/4" C Corp Cock	4 91
150'	3/4" Copper Tubing @ .42		63 00	1	3/4" C Curb Cock	6 28
1	3/4" C Corp Cock		4 91	1	Box & Rod	4 90
3	3/4" C3 Part Unions @ 2.41		7 23			21 24
1	Hr. Trucking @ 3.00		3 00	4/11/63	1 1/2 Straight Tailpiece	50
1	Box & Rod		52 90		1 1/2 Offset Tailpiece	50
			103 08			22 24

DATE _____

TOWN OF LEXINGTON — BOARD OF PUBLIC WORKS
WATER DIVISION

Sketch of Service Here

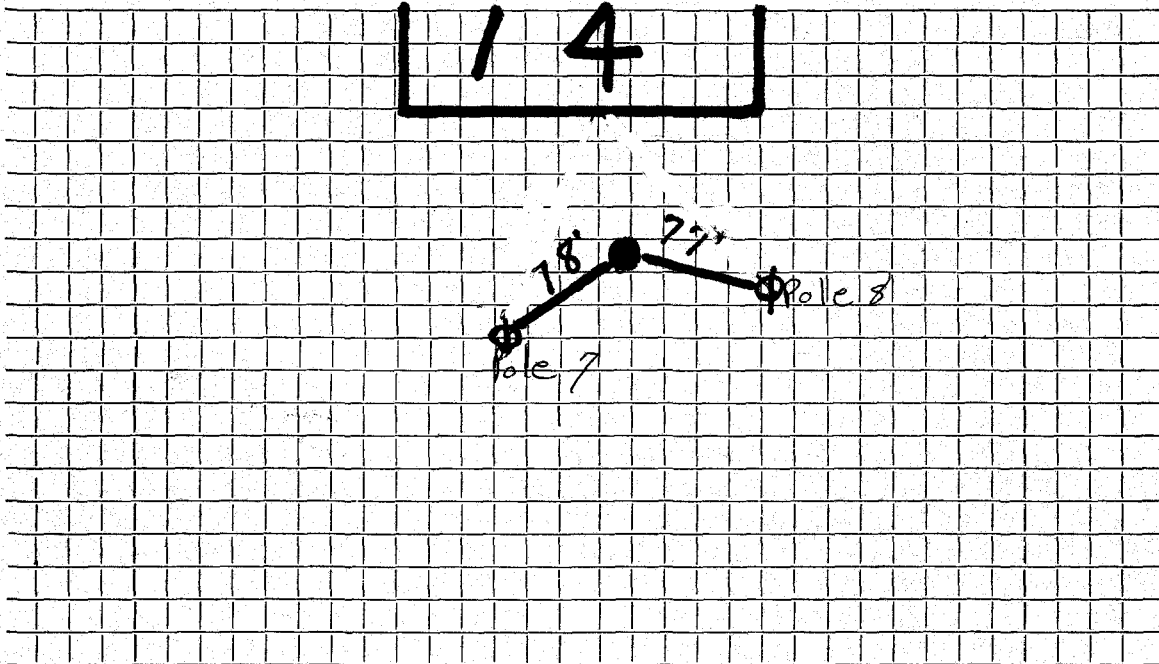

Connection made in Street. Work completed

Remarks:
.....
.....