

WATER SERVICE RECORD

Name Holiday Homes, Inc.

Service No. 12

Address 15 Partridge Road

207F

Location Lot #85 Sta 10/52

~~NEW SERVICE~~ New Service

WO# 7822


Comm 5-27-63

Date	Material	Amount	Total	Date		Amount
4/11/63	Labor	5 74		4-3-63	Deposit	100 00
	10% O.H. ---	57	6 31	5-27-63	Refund	37 76
100	3/4" Copper Tubing @ .42		42 00			62 30
1	3/4" Cx 1/2 I.W.H. Stop & Waste		6 17			
2	3/4" C3 Part Unions @ 2.41		4 82	7/28/61	Labor	7 56
1	Hr. Trucking @ 3.00		3 00		24' 3/4" Copper tubing @ .42	10 08
			62 30		1 3/4" C Corp Cock	4 91
					1 3/4" C Curb Cock	6 28
					1 Box & Rod	4 90
						33 73
				4/11/63	1 1/2 Straight Tailpiece	50
					1 1/2 Offset Tailpiece	50
						34 73
					* Apply 2.43 to WHC# 214 ('61)	
					* " .25 to WHC# 13 ('62)	
					* " 9.85 to WHC# 166 ('62)	
					* " 10.09 to WHC# 182 ('62)	

DATE _____

TOWN OF LEXINGTON — BOARD OF PUBLIC WORKS
WATER DIVISION

Sketch of Service Here

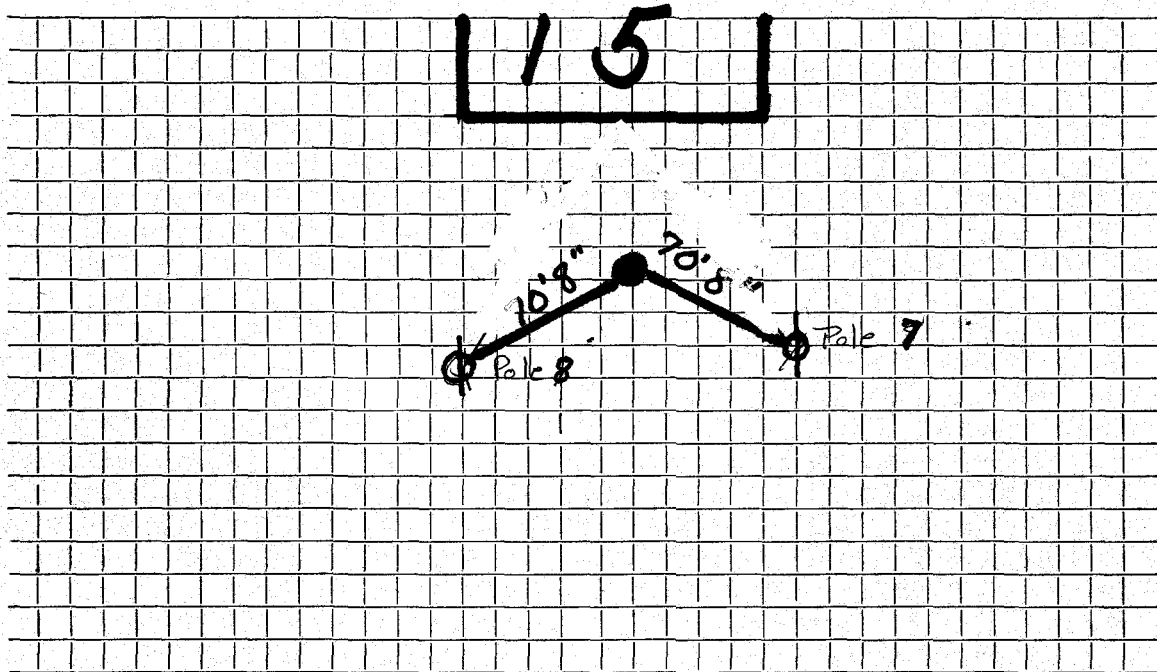

Connection made in Street. Work completed

Remarks:
.....
.....