

WATER SERVICE RECORD

Name Holiday Homes

Service No. 201

Address 18 Partridge Road

Location Lot #67 Sta 12/24

Remarks ~~RENEW~~ - New Service

Comm 12-31-61

Date	Material	Amount	Total	Date	Amount	
8/1/61	Labor	4 73		12-7-61	Deposit	60 00
	10% O.H.	47	5 20	12-31-61	Payment with #185	4
15'	3/4" Copper tubing @ .42		6 30	1-12-62	Paid	43 34
1	Hr. Trucking @ 3.00		3 00			103 34
	BILL WHEN CONNECTED		14 50	8/1/61	Labor	2 52
12/13/61	Labor	32 01			8' 3/4" Copper tubing @ .42	3 36
	10% O.H.	3 20	35 21		1 3/4" C Corp Cock	4 91
92'	3/4" Copper Tubing @ .42		38 64		1 3/4" C Curb Cock	6 28
1	3/4" Cx 1/2 IWH Stop & Waste		6 17		1 Box & Rod	4 90
2	3/4" C3 Part Unions @ 2.41		4 82			21 97
1	Hrs. Trucking @ 3.00		3 00	12/13/61	1 1/2 Straight Tailpiece	50
1	Hr. Pumping @ 1.00		1 00		1 1/2 Offset Tailpiece	50
	PREVIOUS CHARGE		14 50			22 97
			103 34			


Bill sent 42.10

DATE _____

TOWN OF LEXINGTON — BOARD OF PUBLIC WORKS

WATER DIVISION

Sketch of Service Here

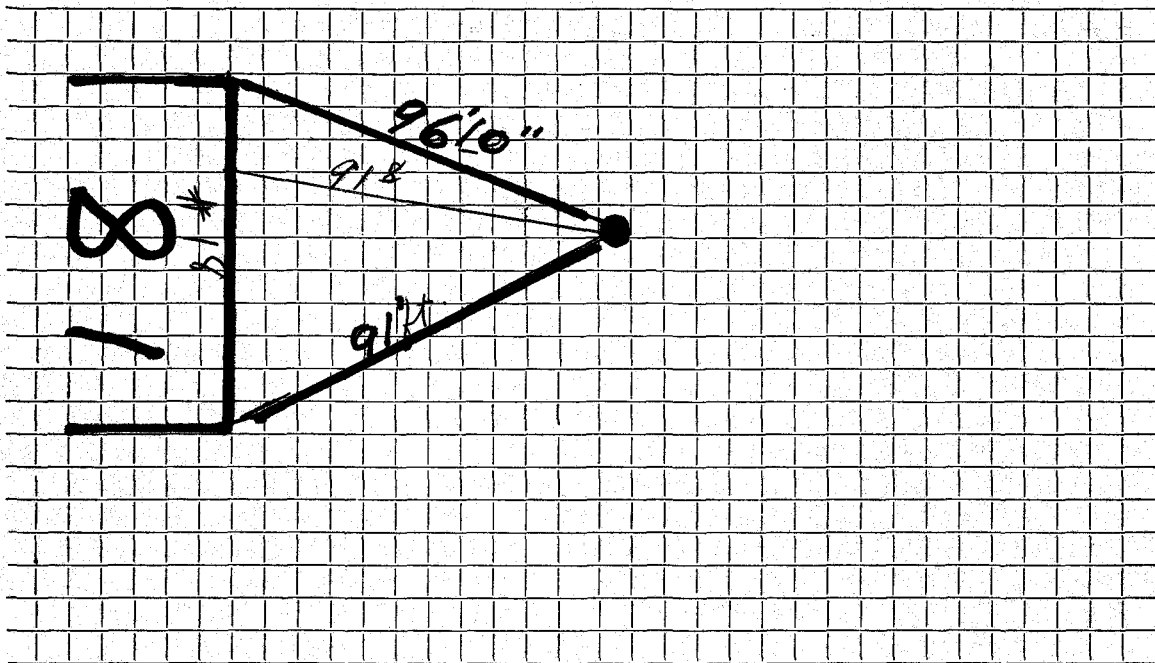

Connection made in Street. Work completed

Remarks:
.....
.....