

WATER SERVICE RECORD

Name Holiday Homes, Inc.

Service No. 202

Address 21 Partridge Road

Location Lot #82 Sta 11/70

677

~~REPAIR~~ New Service WO # 6994


Comm 2-26-62

Date	Material	Amount	Total	Date	Amount
12-13-61	Labor 8.73			12-7-61	Deposit 60.00
12-15-61	" 7.97	16.70		3-29-62	Paid 10.69
	10% O.H.	1.67	18.37		70.69
97'	3/4" Copper tubing @.42		40.74		
1	3/4" C x 1/2 I.W.H. Stop & Waste		6.17	8/1/61	Labor 6.93
1	3/4" C 3 part union		2.41	22'	3/4" Copper tubing @.42 9.24
1	hr. Trucking @3.00		3.00	1	3/4" C Corp Cock 4.91
			70.69	1	3/4" C Curb Cock 6.28
				1	Box & Rod 4.90
4-16-98	REPAIR				32.26
10	LF 3/4" COPPER			1	1/2 Straight tailpiece 50
1	3/4x3/4" UNION			1	1/2 Offset tailpiece 50
					33.26

TOWN OF LEXINGTON — BOARD OF PUBLIC WORKS

WATER DIVISION

Sketch of Service Here

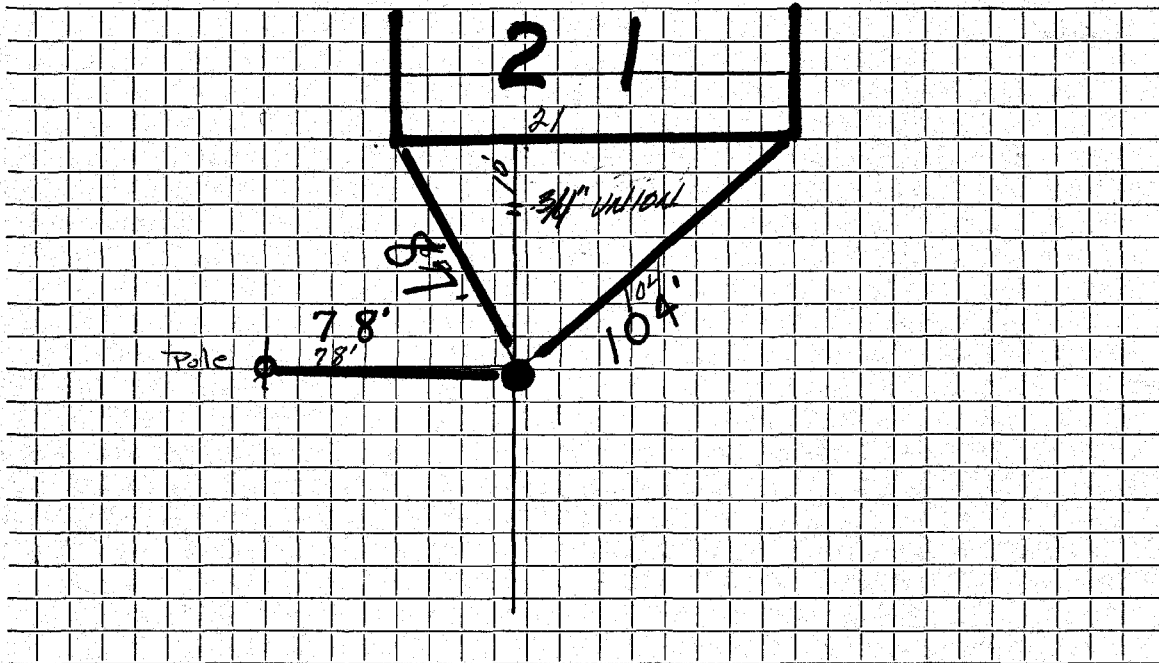

Connection made in Street. Work completed

Remarks:
.....
.....